SURVEY NO. 1257

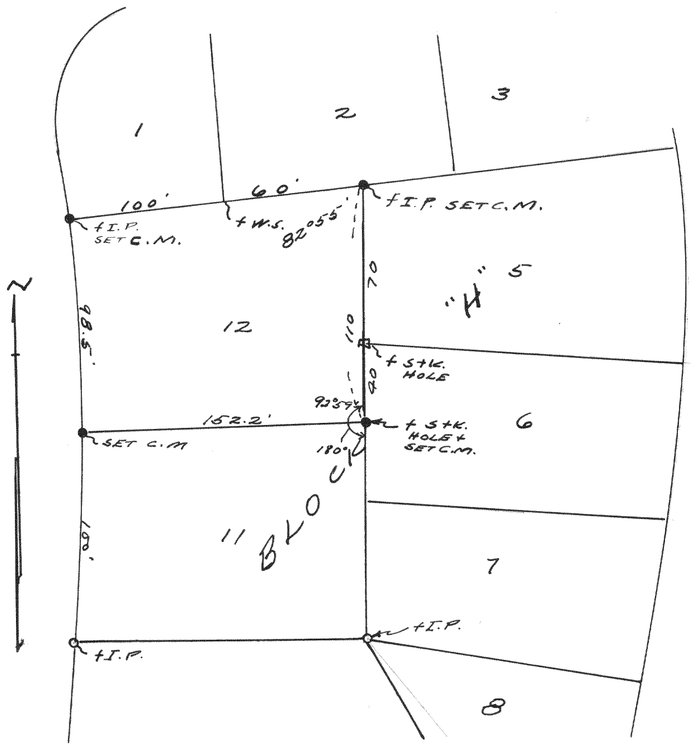

PLAT OF SURVEY OF LOT 12 BLK "H" OF UNIT 3 OF COUNTRY CLUB ESTATES IN THE VILLAGE OF FONTANA-ON-GENEVA-LAKE, WALWORTH CO., WISC.
10-4-41

Lloyd L. Jensen
R.E.J.

SURVEY NO. 1258

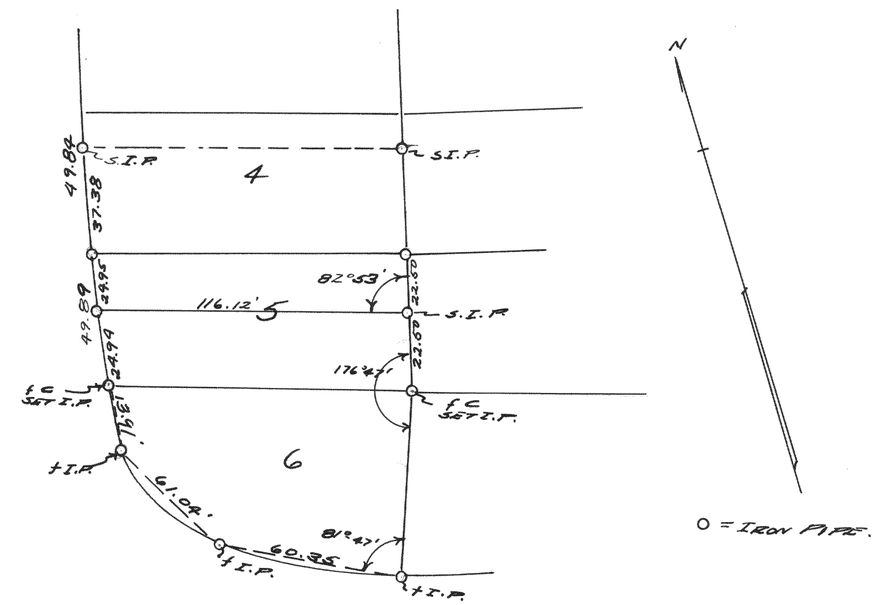

PLAT OF SURVEY OF LOT 6 AND THE SOUTH HALF OF LOT 5 OF BLOCK 3 OF INDIAN HILLS SUBDIVISION, FONTANA, WALWORTH CO., WISC.
AUG. 1941

Lloyd L. Jensen
R.E.J.