2030

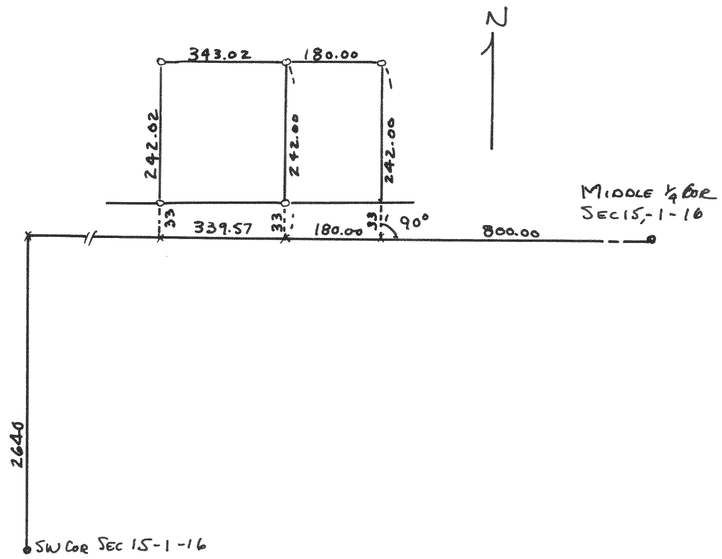

Plat of survey of a parcel of land located in the NW¼ of Sec 15 T1NR1GE
Jan 7, 1949

Lloyd L. Jensen PLS
County Surveyor

2031

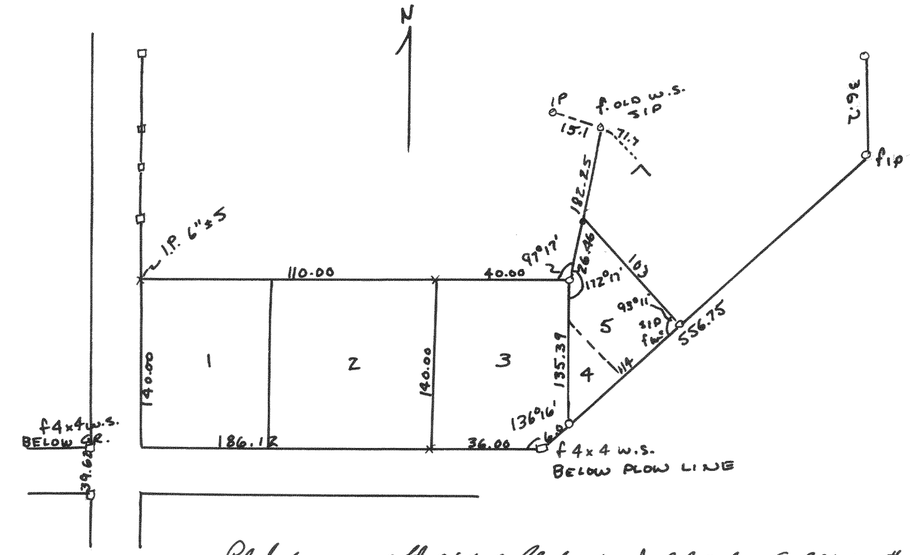

Plat of survey of lots 4 & 5 of Block 6, Inlet Oaks Subdivision #4 located in Sections 15, & 22, T2NR1GE
May 14, 1949

Lloyd L. Jensen PLS
County Surveyor

2032

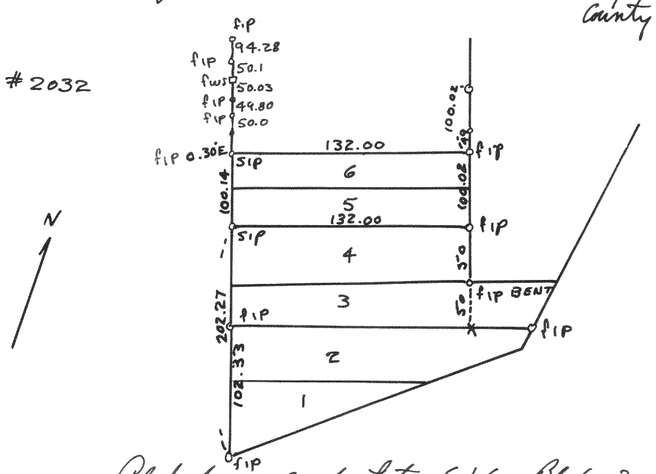

Plat of survey of Lots 5 & 6 Block 3 of the Inlet Oaks Subd. located in Sections 15 & 22, T2NR1GE
May, 1949

Lloyd L. Jensen
County Surveyor

2033

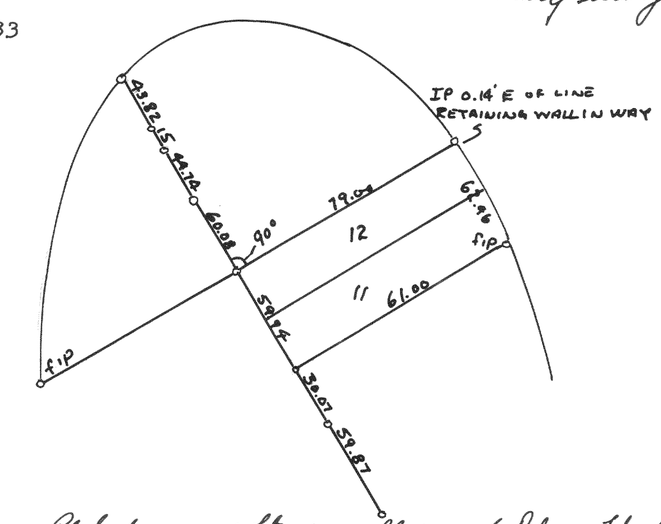

Plat of survey of lots 11, 12 Block I of Delavan Lake Assembly Grounds located in SE¼ Sec 21, T2NR1GE
May 20, 1949

Lloyd L. Jensen PLS
County Surveyor