SURVEY NO. 1261

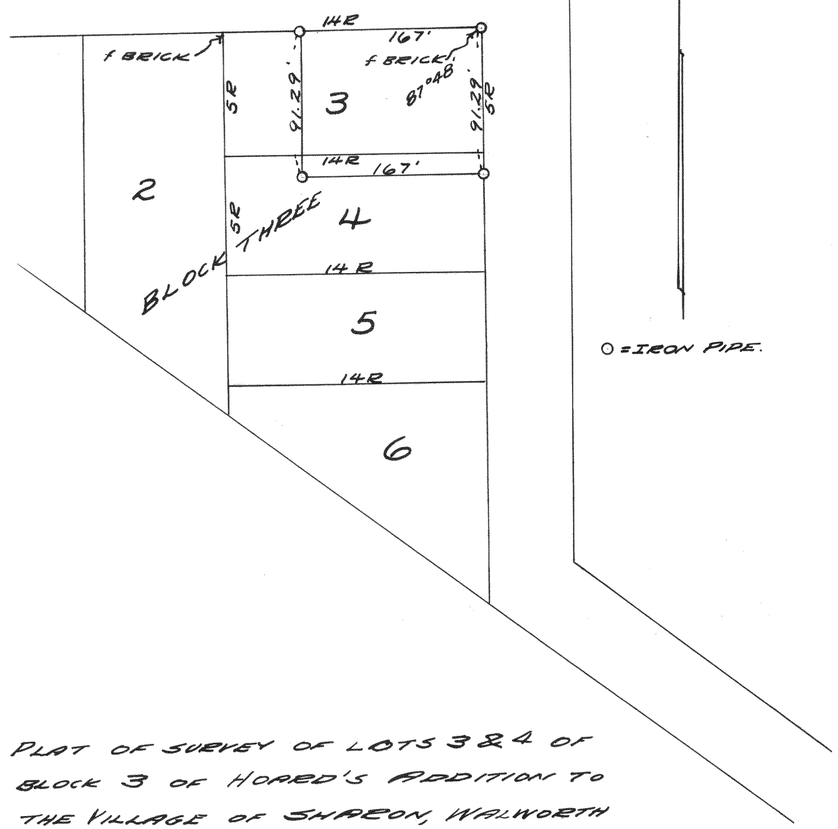


PLAT OF SURVEY OF LOTS 3 & 4 OF BLOCK 3 OF HORED'S ADDITION TO THE VILLAGE OF SHARON, WALWORTH COUNTY, WISCONSIN.

OCT., 14, 1941

Lloyd L. Jensen
R.E.G.

SURVEY NO. 1262

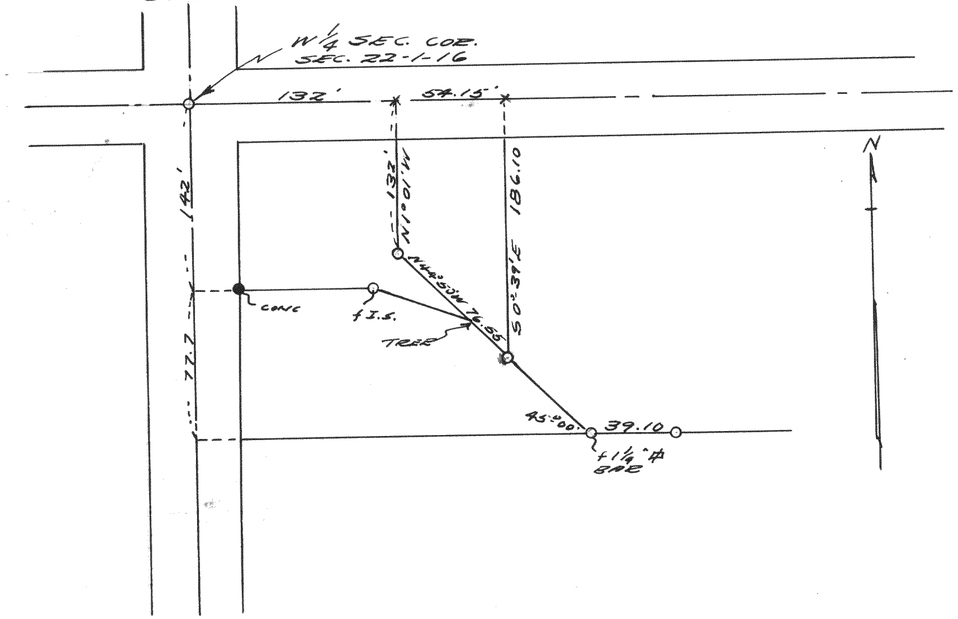


PLAT OF SURVEY OF PART OF THE SW 1/4 OF SECTION 22 T1N R16E IN THE VILLAGE OF WALWORTH, WALWORTH COUNTY, WISCONSIN.

FEB. 17, 1941

Lloyd L. Jensen
R.E.G.