# 2087

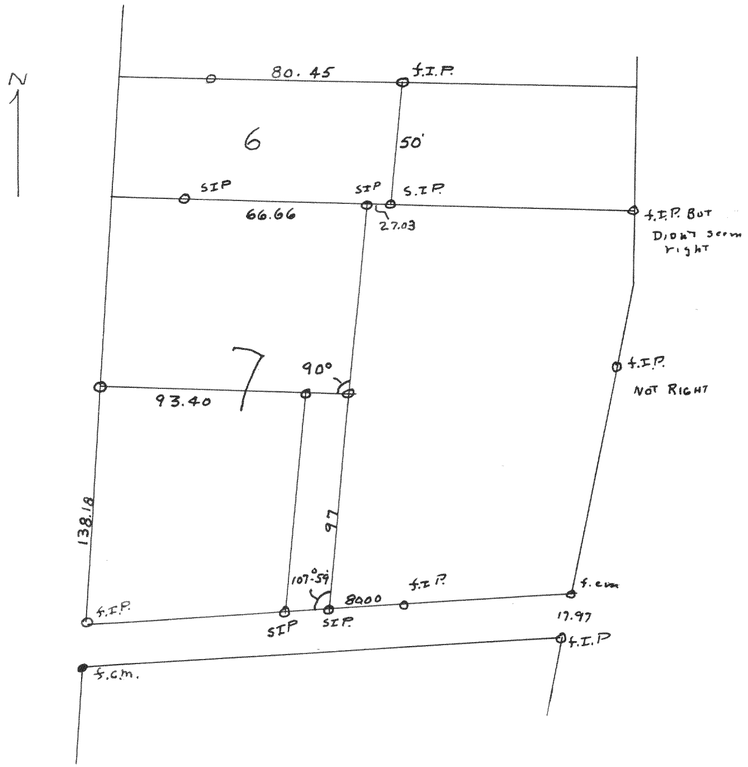


Plat of survey of lots 6 & 7 of Zudde Subdivision
located in Section 13, T1NR18E of Walworth County
April 16, 1949

Lloyd L. Jensen
County Surveyor

# 2088

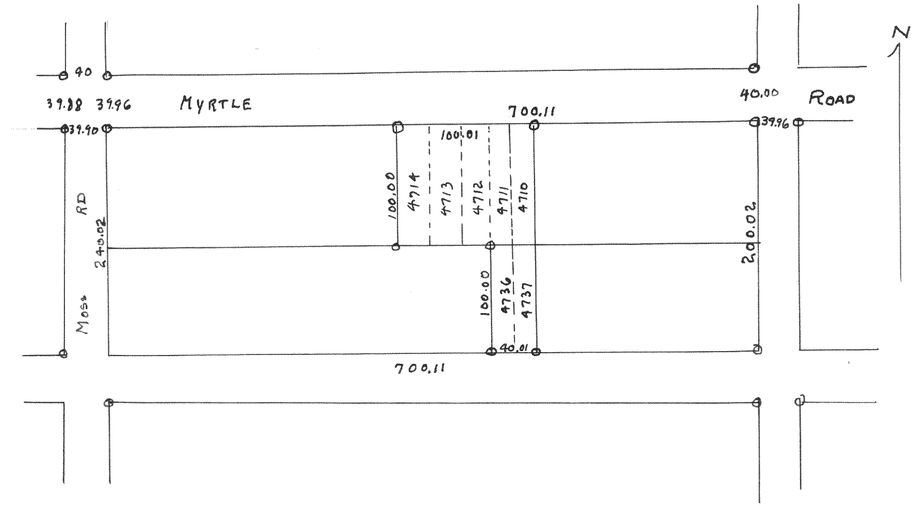


Plat of survey of lots 4736-7 & 4710-4714 Section 3 of Bell Lake
Subdivision Walworth County
May 7, 1949

Lloyd L Jensen
County Surveyor

# 2089

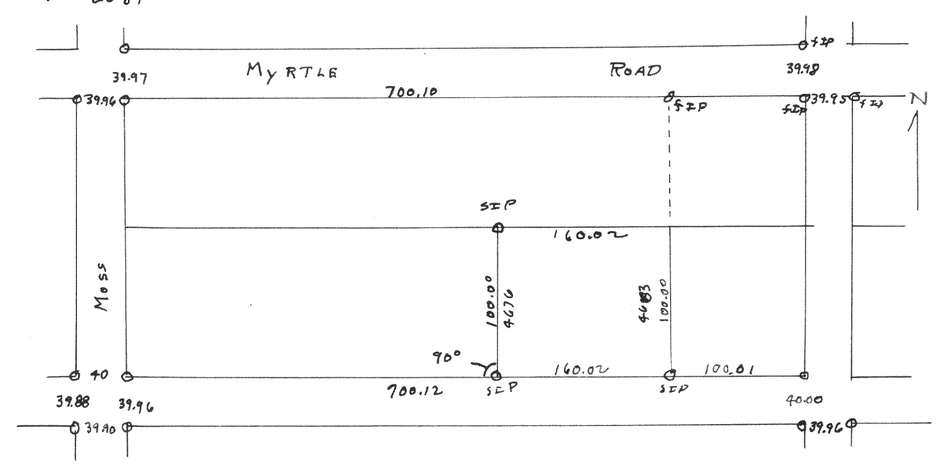


Plat of survey of lots 4676 - 4683 Bell Lake Subdivision T1NR18E
Walworth County
May 7, 1949

Lloyd L Jensen
County Surveyor