2118

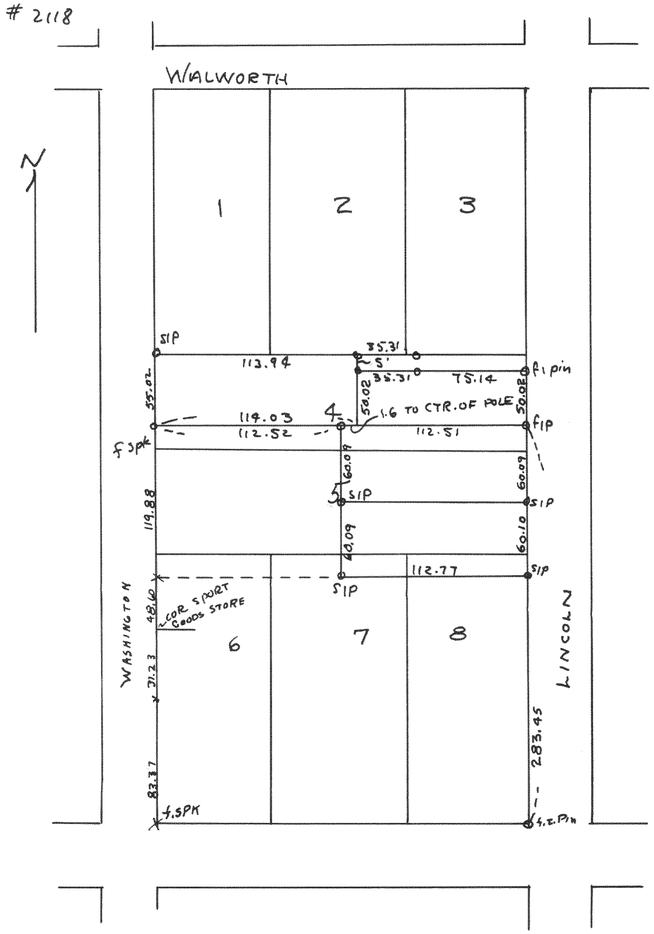

Plat of survey of part of lots 4, 5, 7 & 8 Block 24 of Original Plat. City of Elkhorn Walworth County 1999

Lloyd L Jensen
County Surveyor

2110

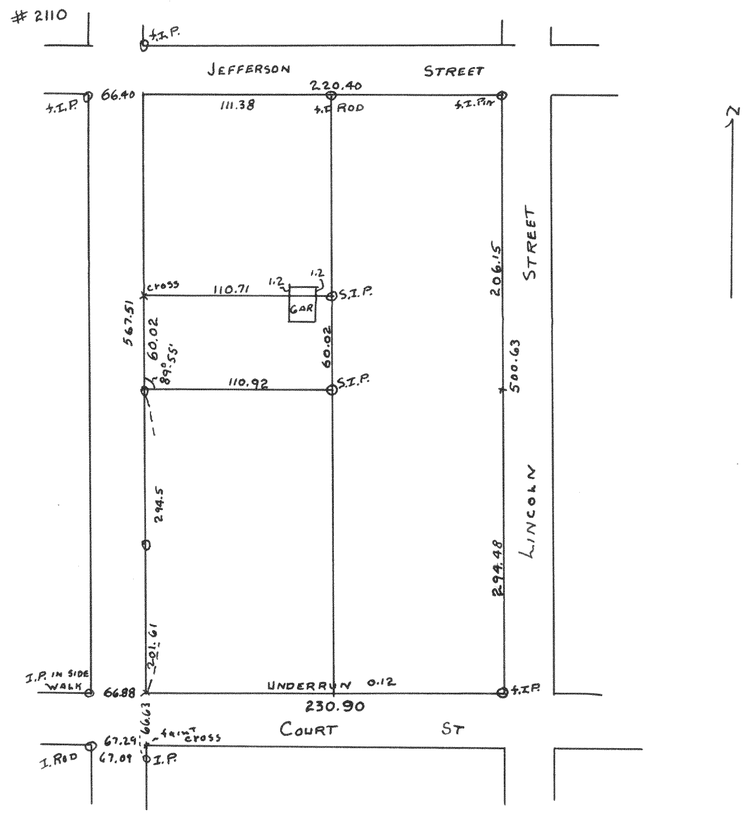

Plat of survey of parts of lots 2, 3, 8 & Block 14 of the Original Plat of the City of Elkhorn Walworth County April 13, 1949

Lloyd L Jensen
County Surveyor