2384

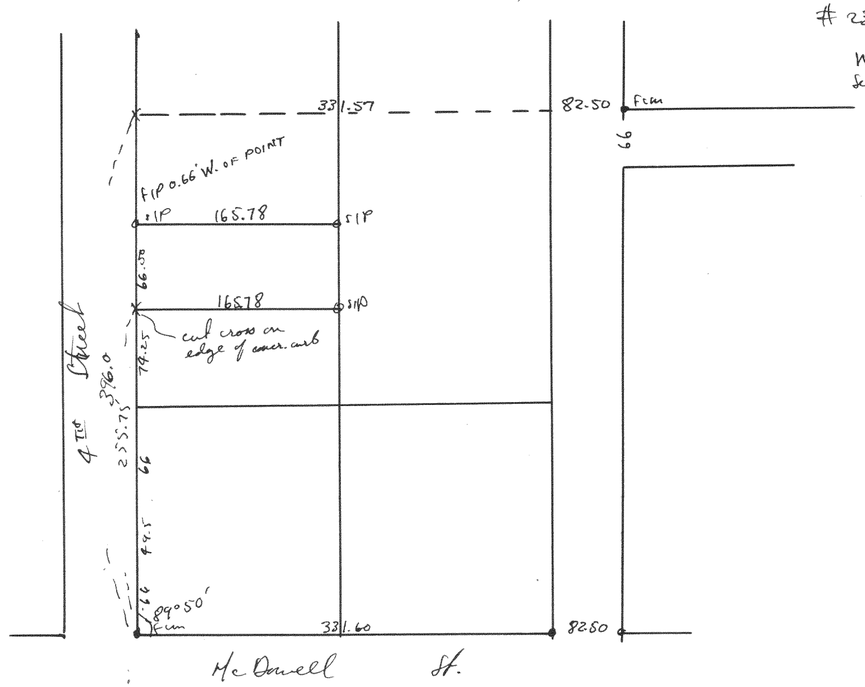

Plat of survey of a parcel of land located on N 4th St in the NE¼ Sec 18, T2N R17E, City of Delavan Walworth Cty, Wis.
October 21, 1950

Floyd L. Jenson
County Surveyor

2385

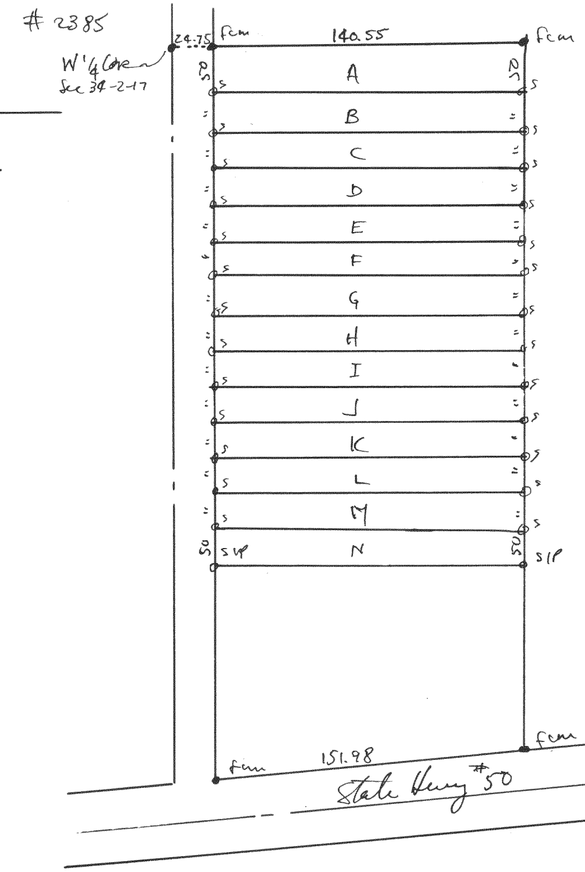

Plat of survey of land located in the SW¼ of Sec 34, T2N R17E of Walworth County, Wis.
1948

Floyd L. Jenson
County Surveyor

2386

Survey of Unit 6, Addition A, Country Club Estates located in Sec 14, T1N R16E, Village of Fontana, Walworth Cty, Wis.
Plat is on record in the Register of Deeds office in the Court House, Elkhorn, Walworth Cty, Wis.
Dec 1950

Floyd L. Jenson
County Surveyor