2538

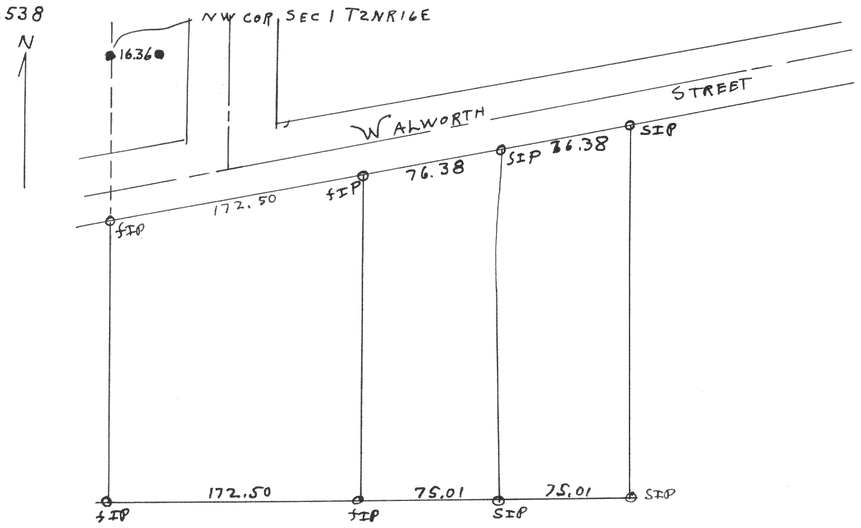

Plat of survey of Alder Lots located in the NW1/4 of Section 1 T2NR16E Walworth County, Wisconsin
July 1951

Lloyd S Jensen
County Surveyor

2539

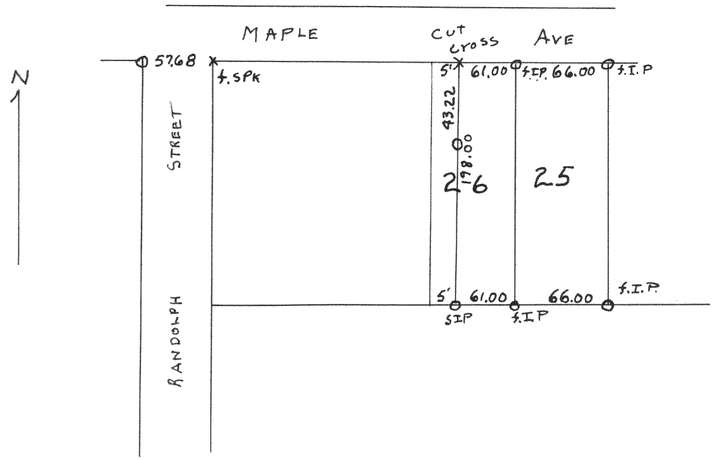

Plat of survey of part of lot 26 of Clarkes Addition located in the SW 1/4 of Section 22, T1NR16E Village of Walworth Walworth County, Wisconsin
1951

Lloyd S Jensen
County Surveyor

2540

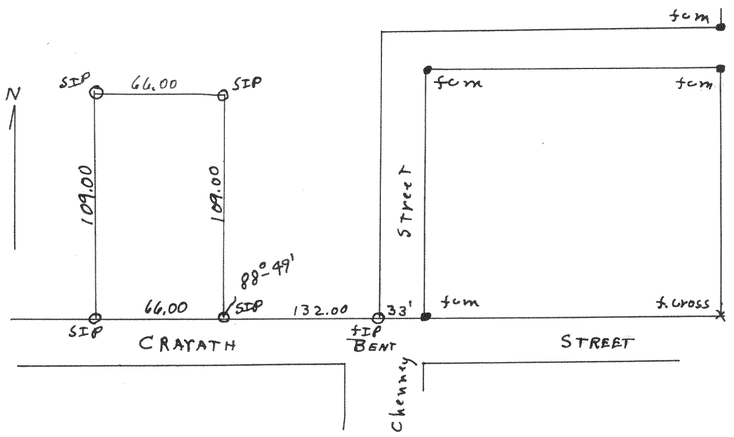

Plat of survey of land located in the NE1/4 of Section 4 T4NR15E City of Whitewater, Walworth County, Wisconsin
May 19, 1951

Lloyd S Jensen
County Surveyor

2541

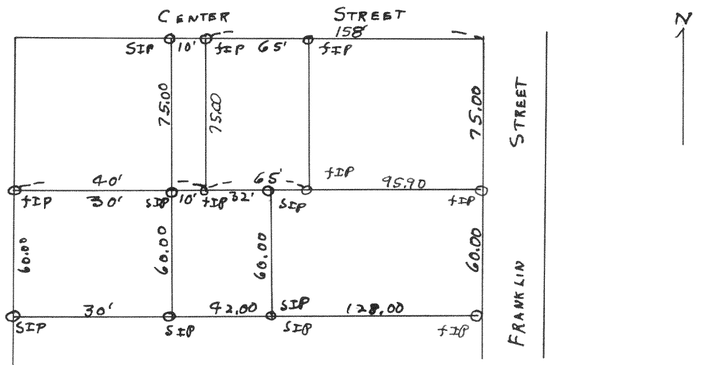

Plat of survey of Rockel land located in Block 22 of Chapman & Ludingtons Addition SE1/4 Sec 5 T4NR15E City of Whitewater, Walworth County Wisconsin
1951

Lloyd S Jensen
County Surveyor