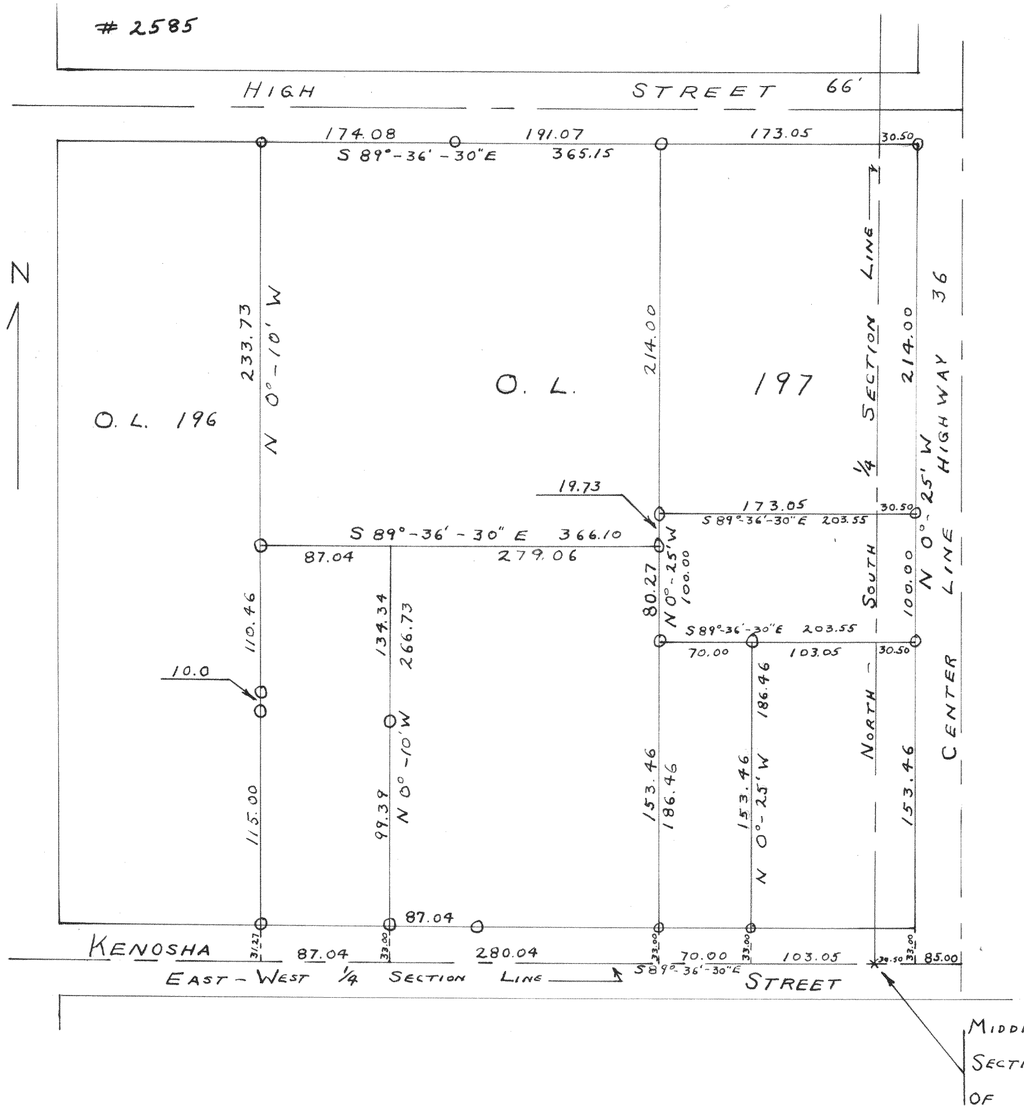

PLAT OF SURVEY OF LAND LOCATED IN OUTLOT 197 VILLAGE OF WALWORTH AND LAND IN NORTH-EAST 1/4 OF SECTION 22, T1N, R16E WALWORTH COUNTY, WISCONSIN
FEBRUARY 1952

Lloyd L. Jensen SA
COUNTY SURVEYOR

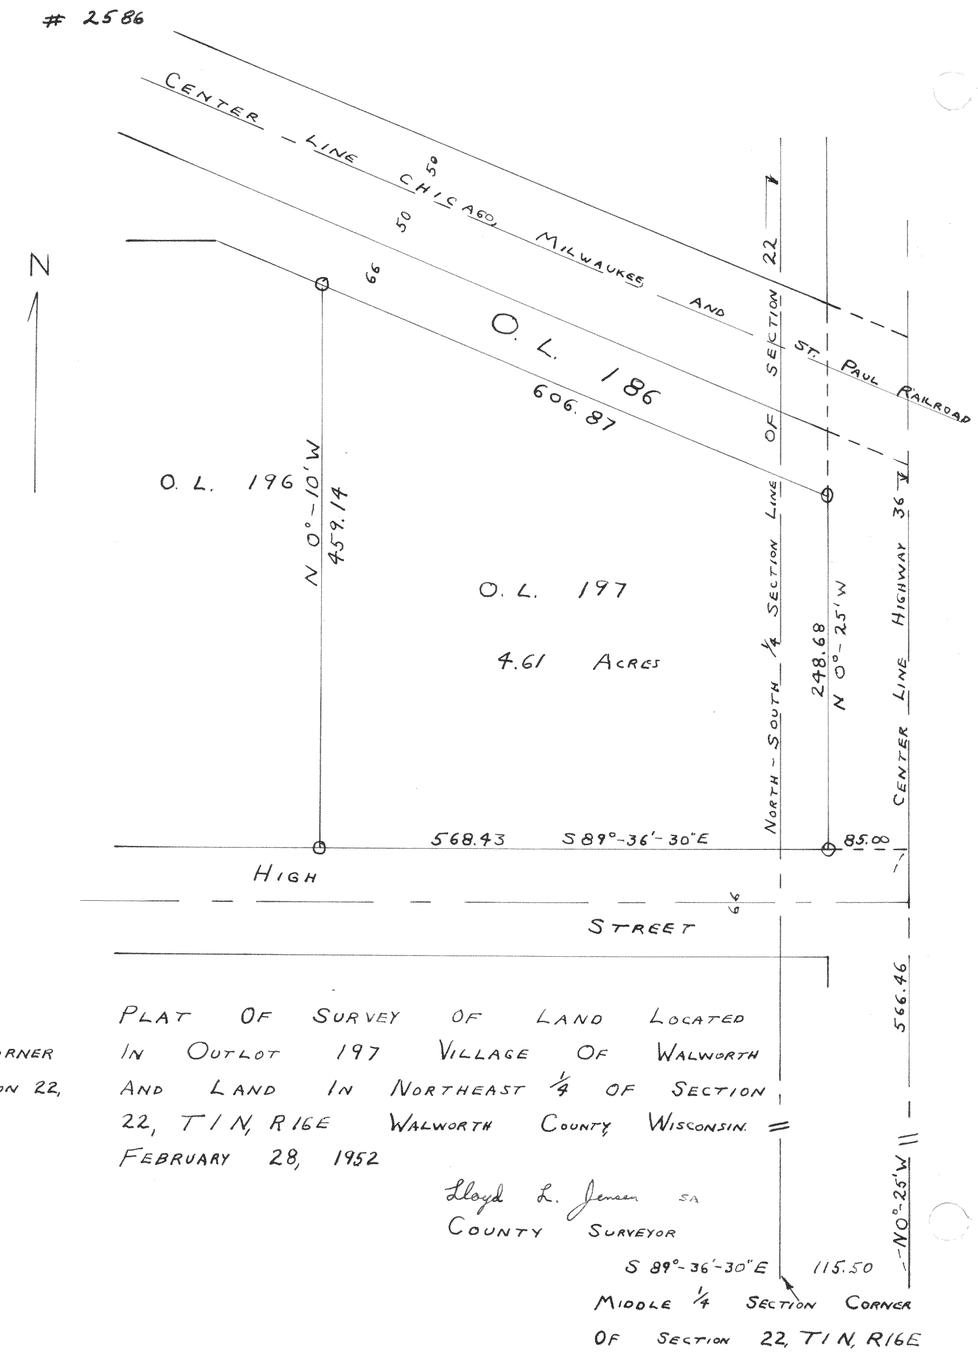

PLAT OF SURVEY OF LAND LOCATED IN OUTLOT 197 VILLAGE OF WALWORTH AND LAND IN NORTHEAST 1/4 OF SECTION 22, T1N, R16E WALWORTH COUNTY WISCONSIN.
FEBRUARY 28, 1952

Lloyd L. Jensen SA
COUNTY SURVEYOR