SURVEY NO. 1201

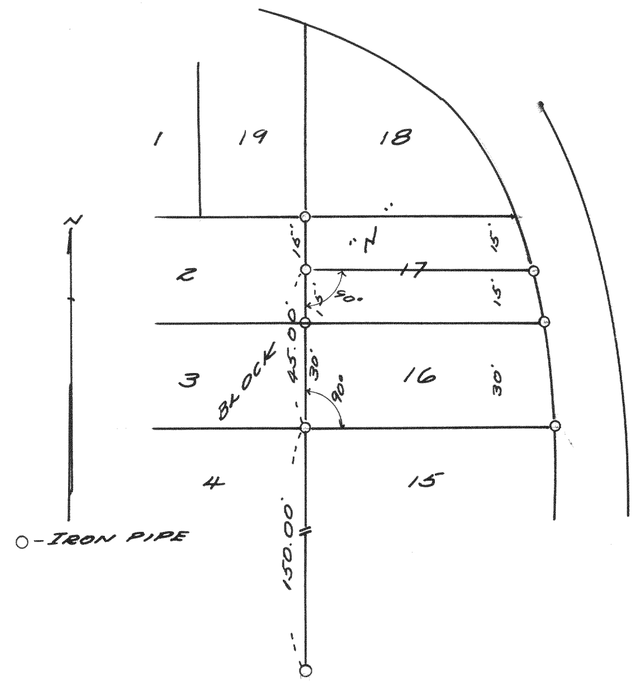


PLAT OF SURVEY OF LOT 16 & THE SOUTH ½ OF LOT 17 OF BLOCK "N" OF DELAVAN LAKE ASSEMBLY PARK, WAL. CO., WISC.
JUNE 26, 1941

Lloyd L. Jensen
R.E.J.

SURVEY NO. 1202

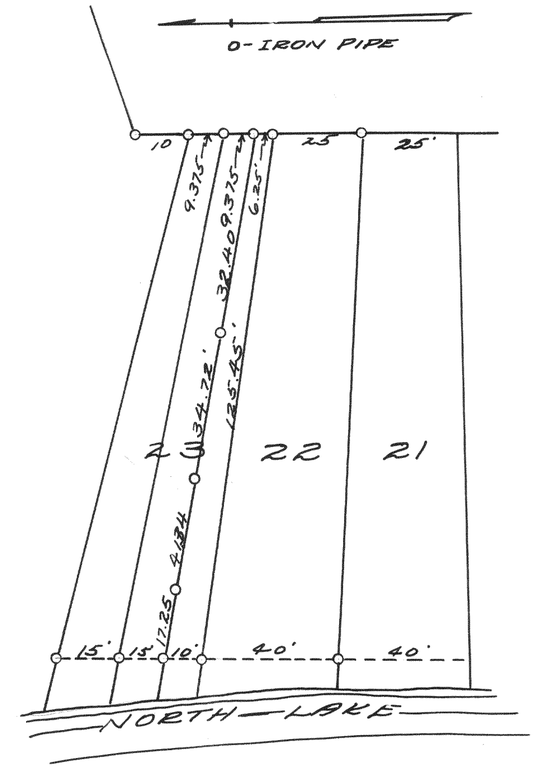


PLAT OF SURVEY OF PART OF LOT 23, BLOCK 1, OF NORTH LAKE ~~BEACH~~, SHORE WOODS, SECTION 5 T3N R16E, WALWORTH COUNTY, WISCONSIN.
JUNE, 1941

Lloyd L. Jensen
R.E.J.