#1594

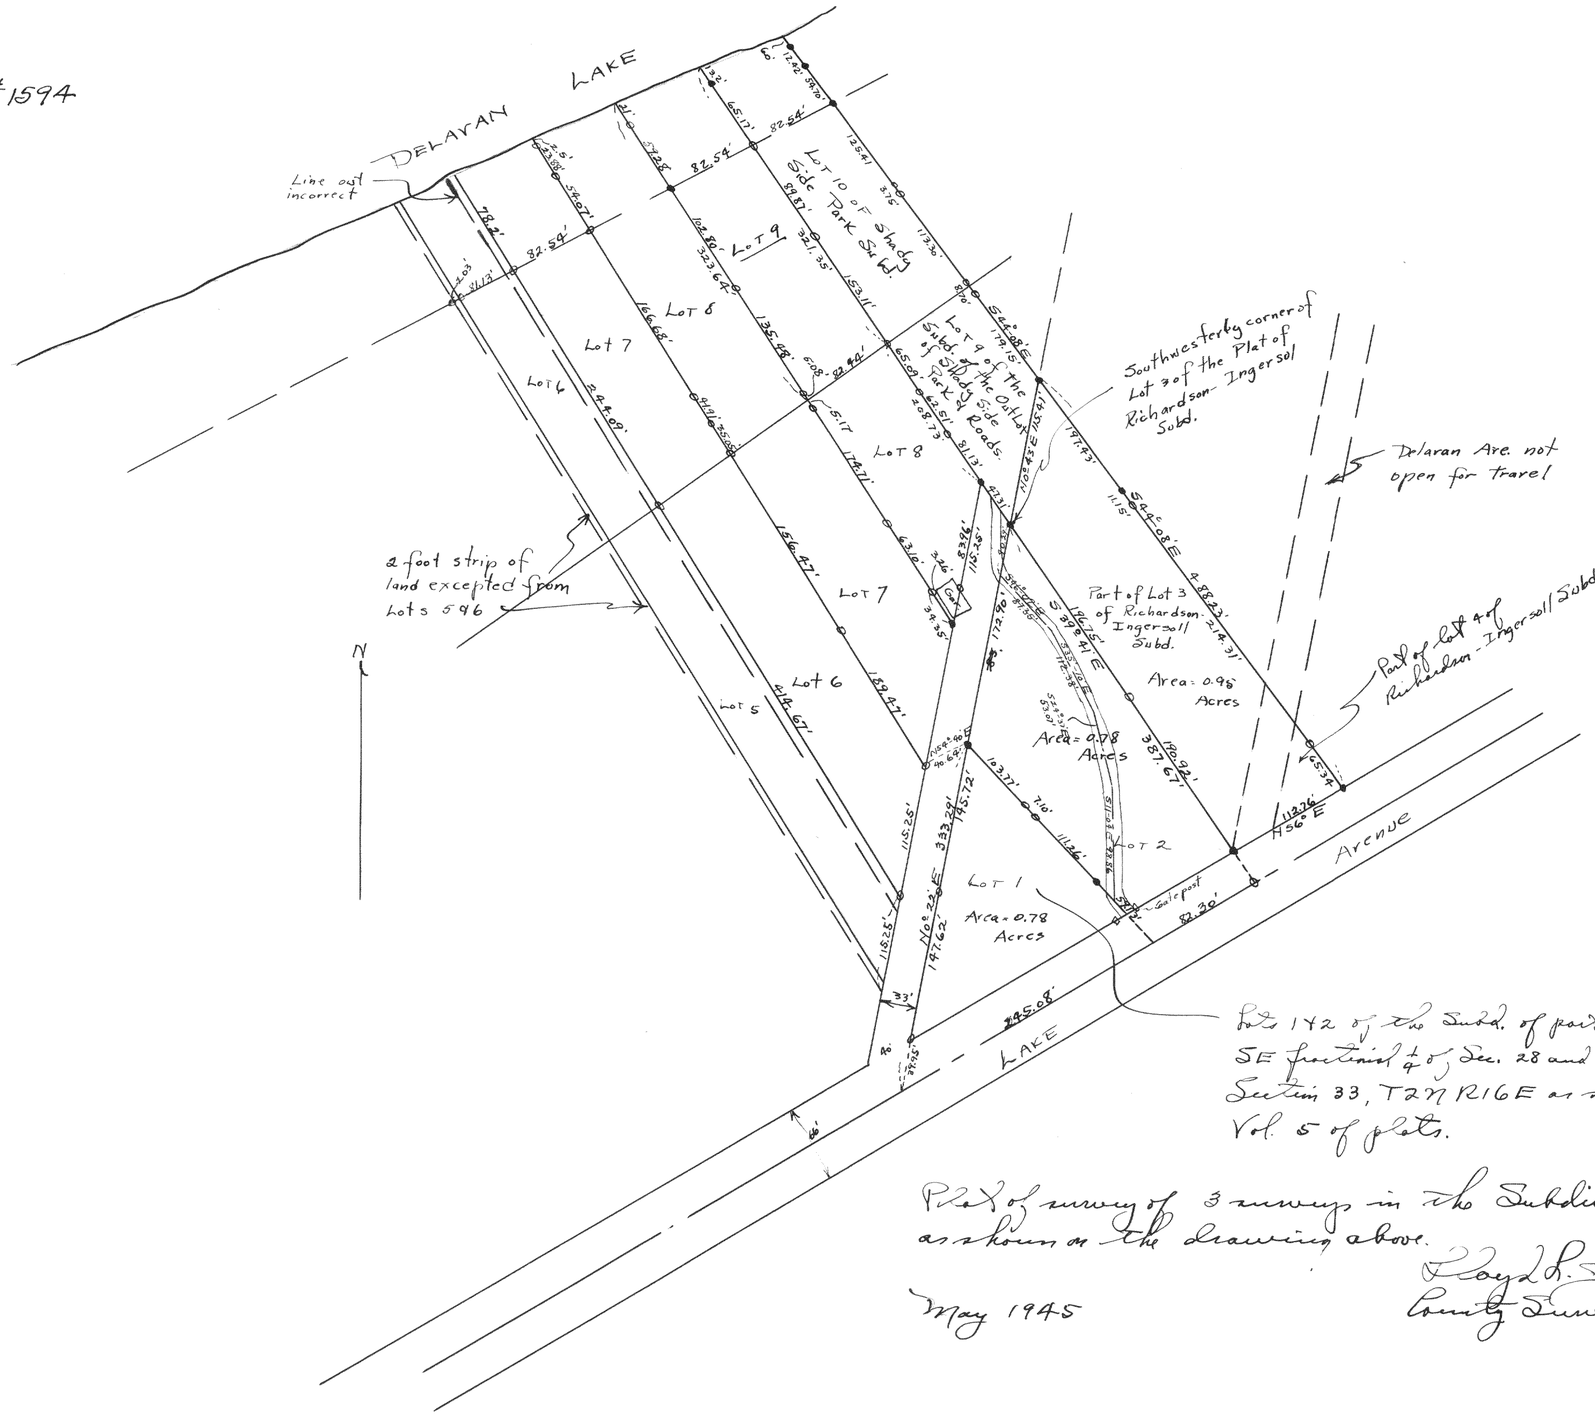

Lots 1 & 2 of the Subd. of part of Lot 14 in "Map of the SE fractional ¼ of Sec. 28 and the NE fractional ¼ of Section 33, T2N R16E as shown on page 300 of Vol. 5 of plats.

Plat of survey of 3 surveys in the Subdivisions as shown on the drawing above.

Floyd L. Lemon
County Surveyor

May 1945