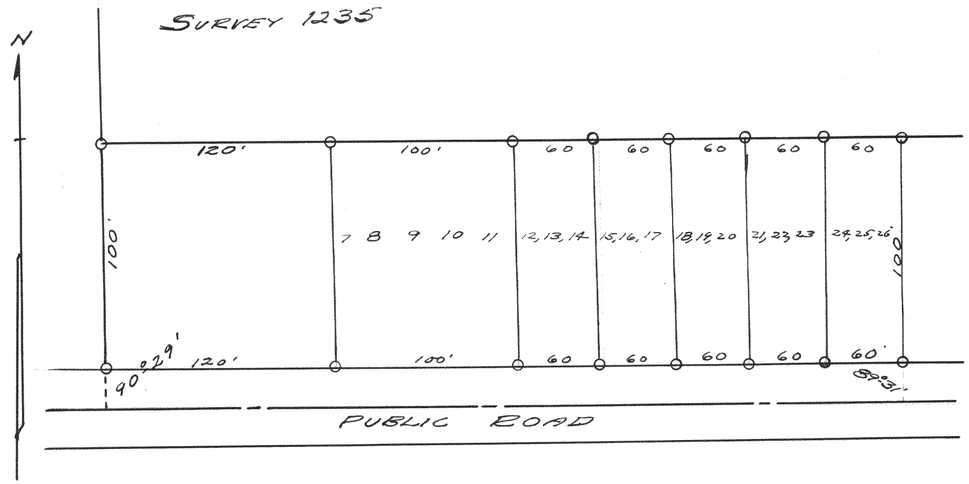

PLAT OF SURVEY OF LOTS 7 TO 26 INC. OF PELL FARM ANNEX
AUG. 1941

Lloyd L. Jensen
R.E.J.

SURVEY NO. 1236

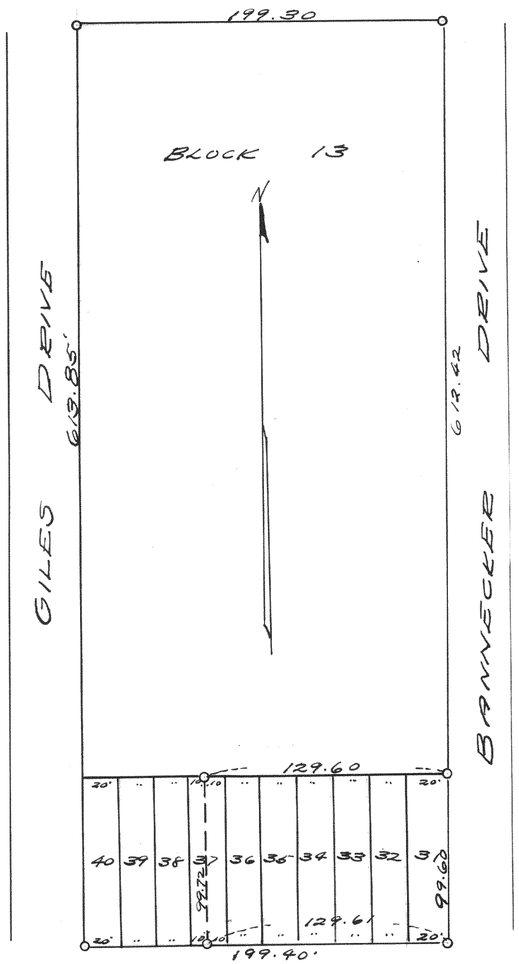

PLAT OF SURVEY OF LOTS 31 TO 36 OF BLOCK 13, OF LAKE IVANHOE SUBD., WALWORTH COUNTY, WISCONSIN.
APRIL, 1941

Lloyd L Jensen
R.E.J.