#1789

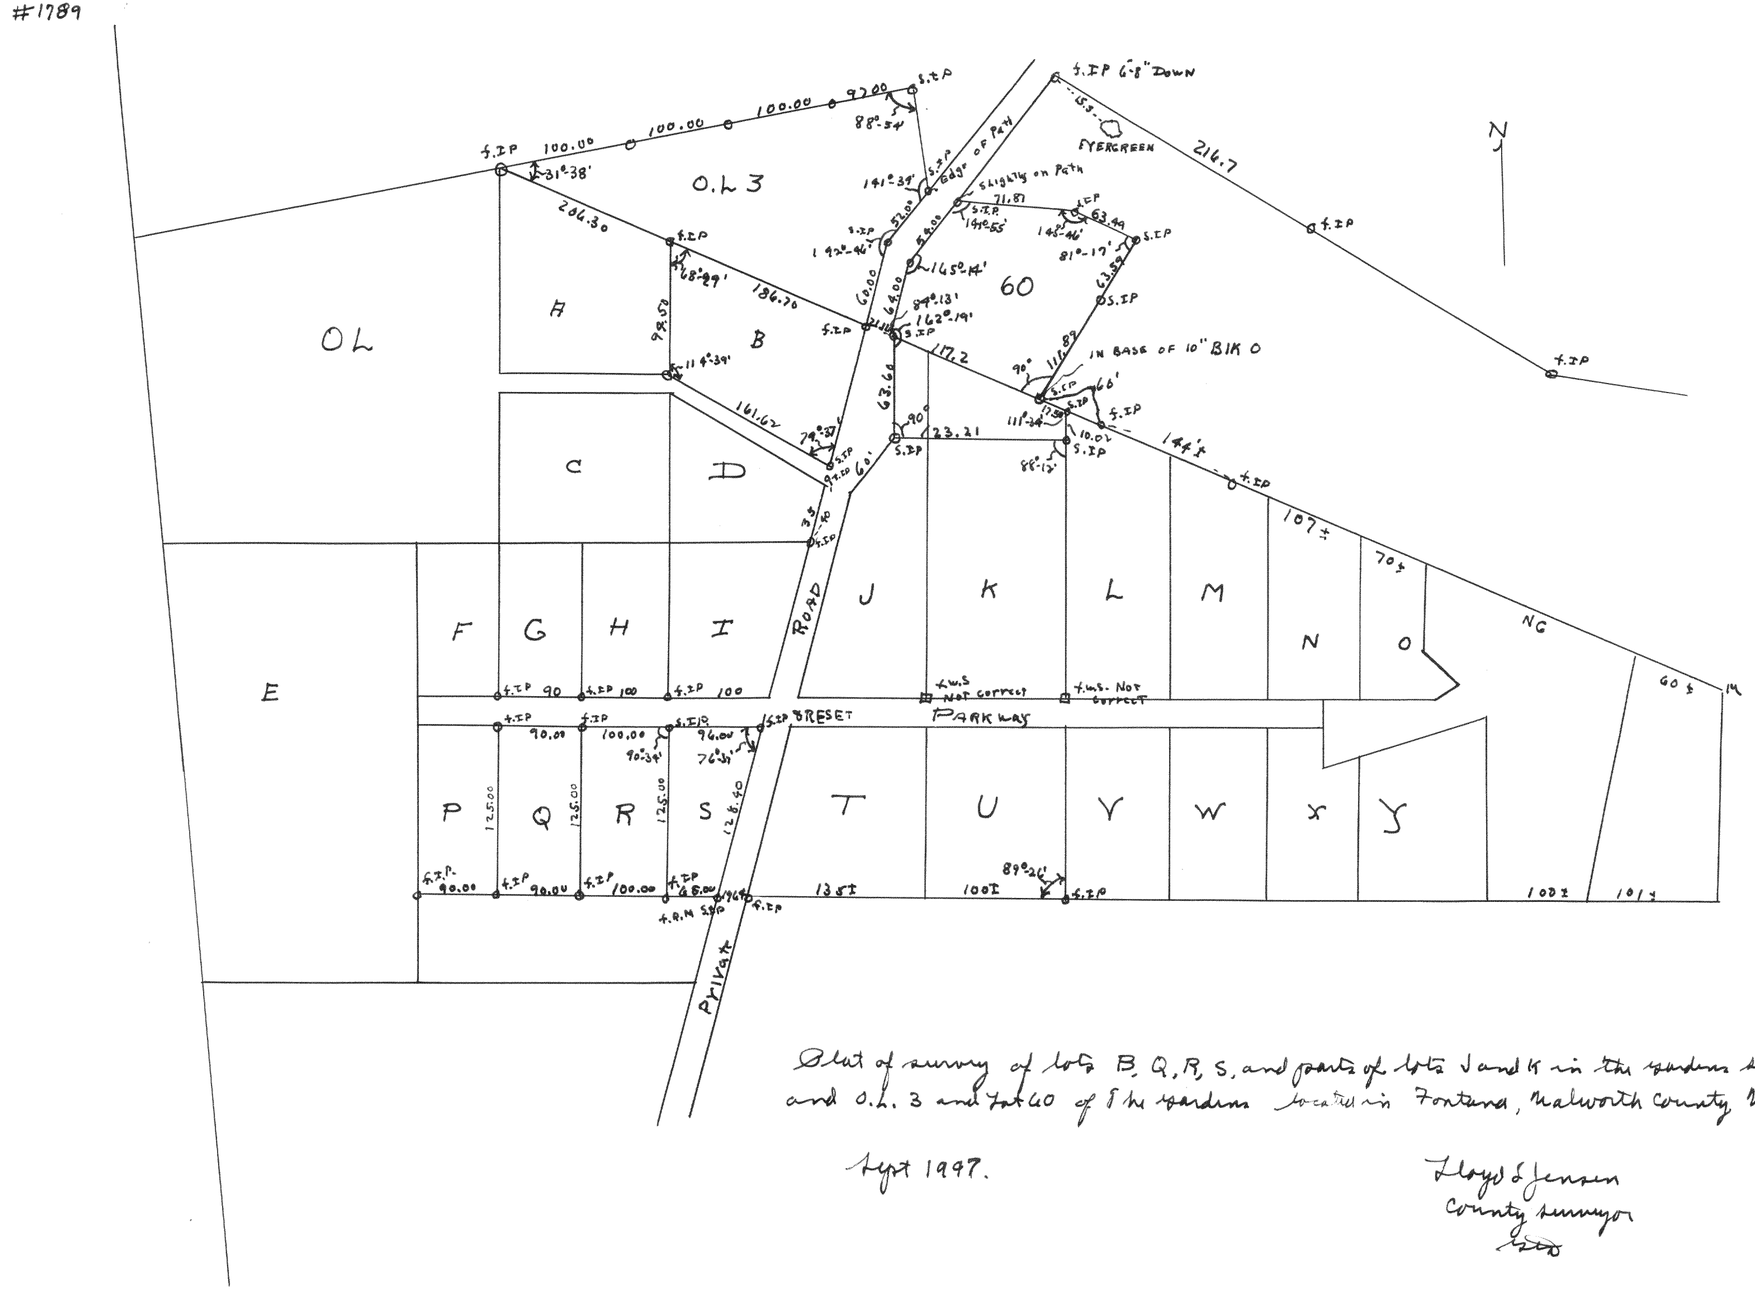

Plat of survey of lots B, Q, R, S, and parts of lots J and K in the gardens subdivision #2 and O.L. 3 and lot 60 of the gardens located in Fontana, Walworth County, Wisconsin.

Sept 1997.

Lloyd G Jensen
County Surveyor
1220