1811

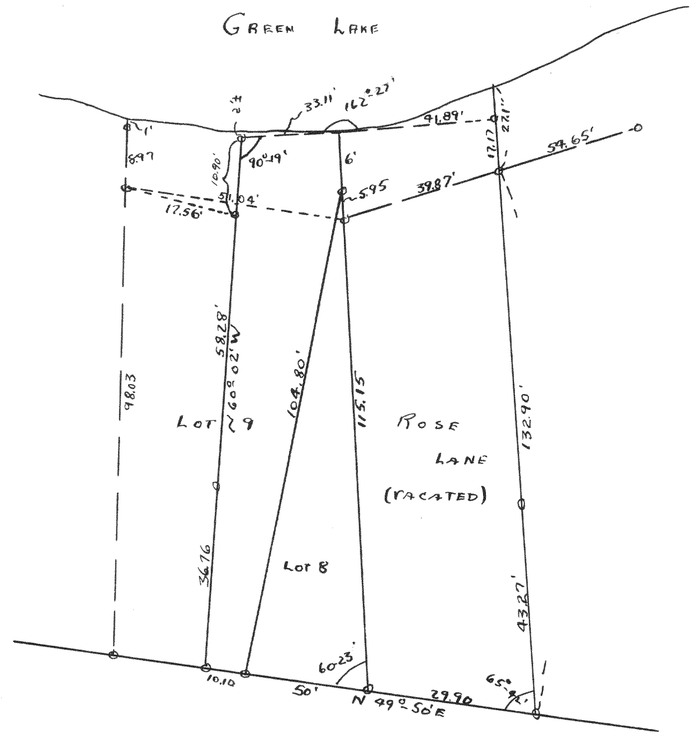

Plat of survey of Rose Lane, Lot 8 and part of Lot 9 of Green Island Subd, located in section 26, T4N, R16E Walworth, County.

1947

Lloyd I Jenson
County Surveyor

1812

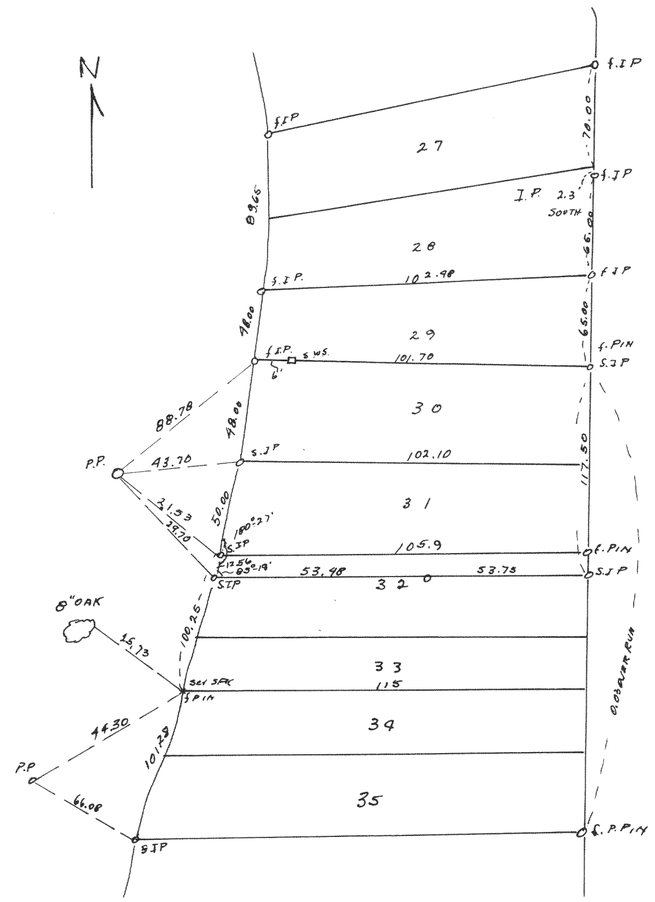

Survey lots 29, 30, 31, & 12.5' of 32 of Black 1 Indian Hills Subd. in the Village of Fontana Walworth, County.
July 1, 1948

Lloyd L Jensen
County Surveyor
ea.