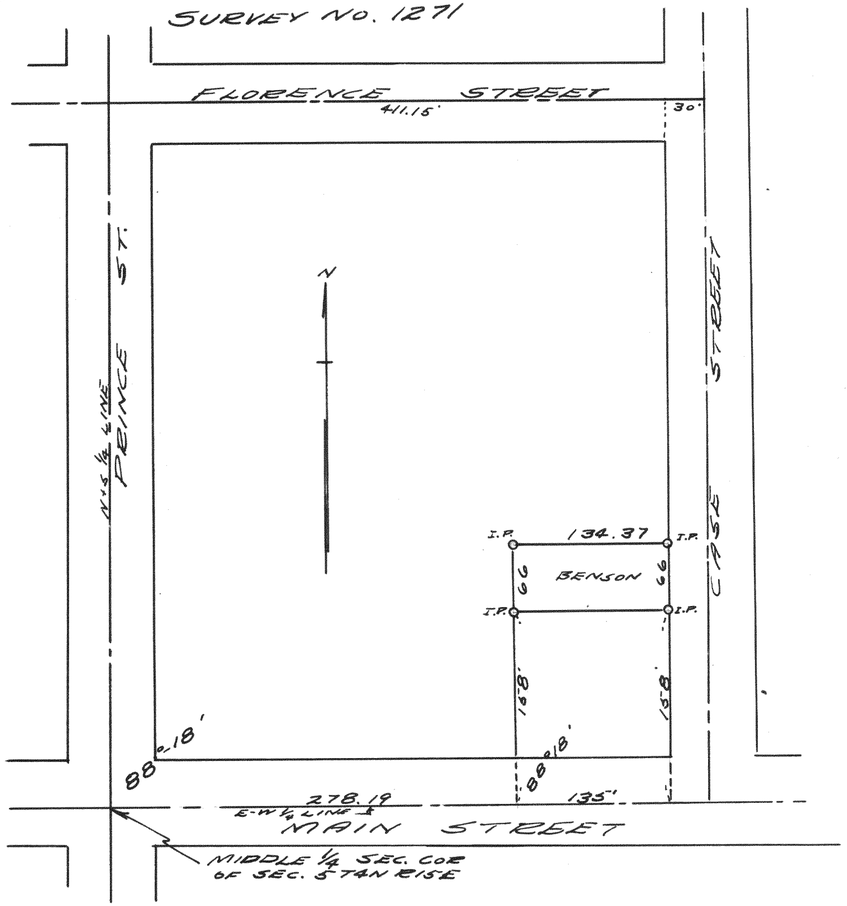

PLAT OF SURVEY OF LAND LOCATED IN THE NORTHWEST ¼ OF SECTION 5 TAN R15E, IN THE CITY OF WHITEWATER, WALWORTH CO. WISCONSIN
APRIL, 1941

Lloyd L. Jensen
R.E.J.

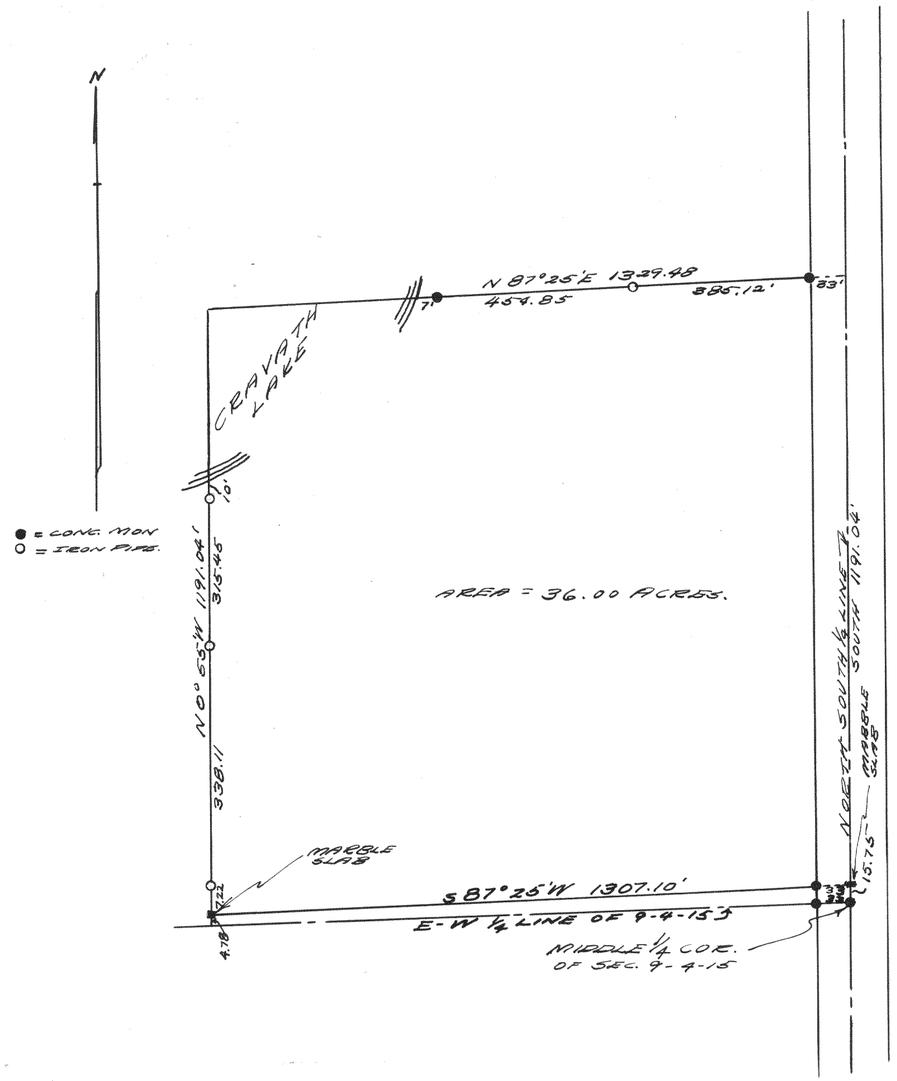

PLAT OF SURVEY OF LAND LOCATED IN THE NORTHWEST ¼ OF SECTION 9 TAN R15E, IN THE CITY OF WHITEWATER, WALWORTH CO., WISCONSIN.
JULY 25, 1941

Lloyd L. Jensen
R.E.J.