#2407½

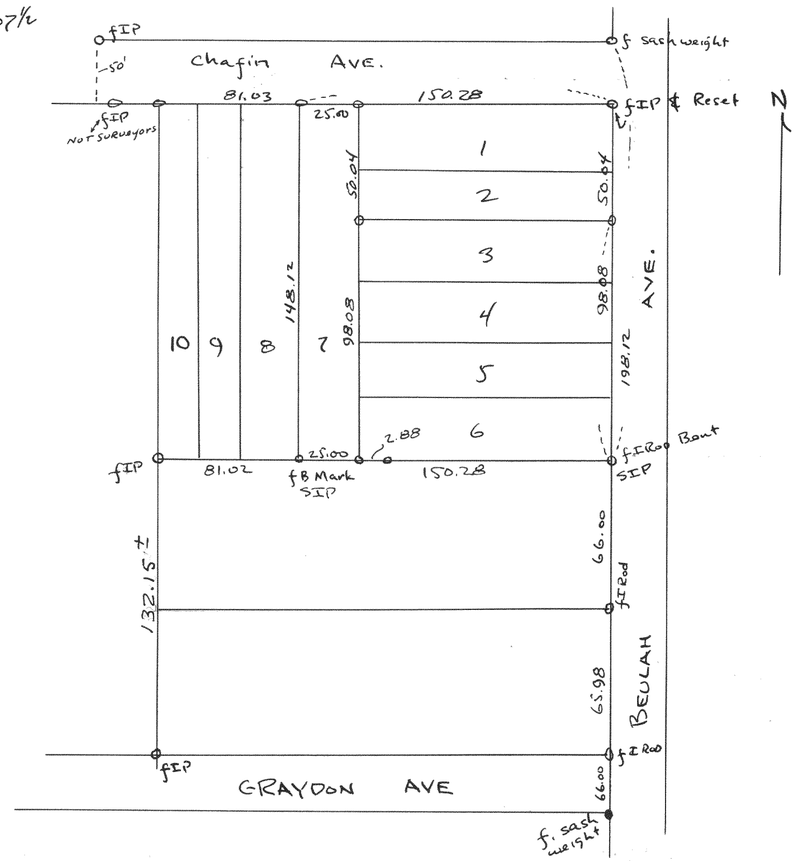

Plat of survey of lots 1, 2, 7 & parcel to the South of Clarks addition, Village of East Troy, Walworth County, Wisconsin
1951

Floyd L. Jensen RLS
County Surveyor

#2408

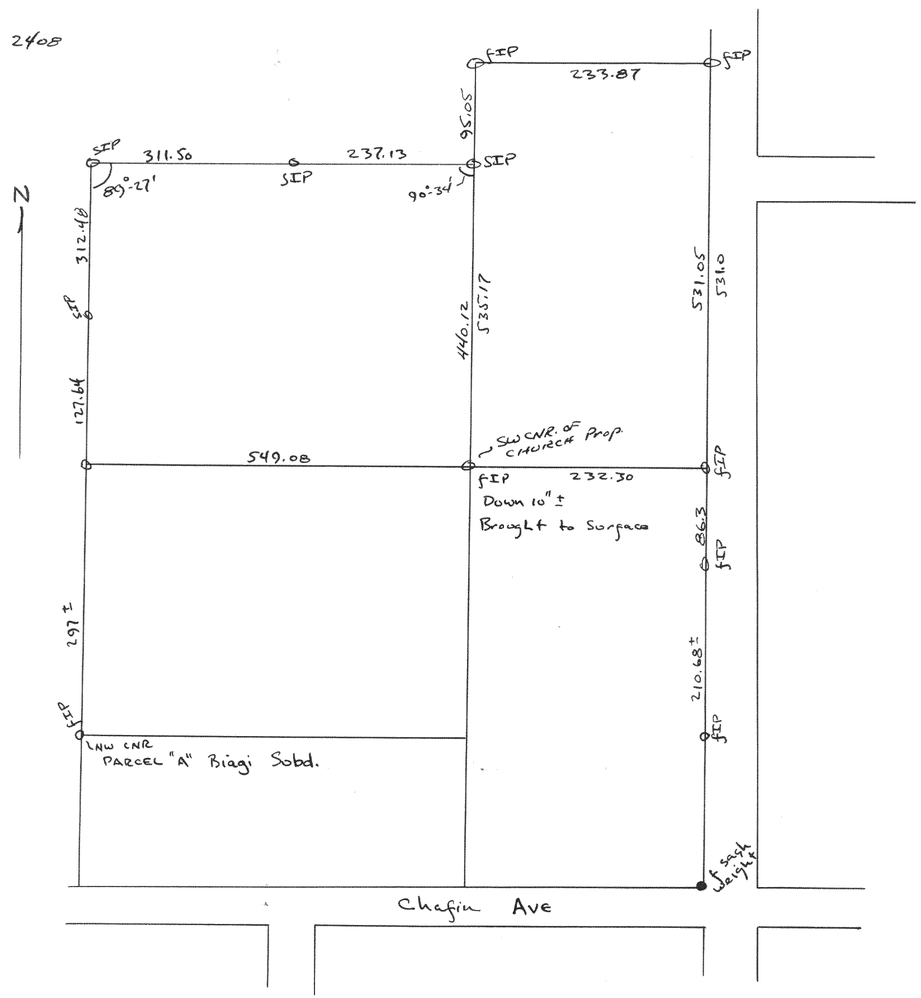

Plat of survey of land purchased by Catholic Church located to the west of present Church in the SE 1/4 of Section 19, T4N R18E, Village of East Troy, Walworth County, Wisconsin
July 24, 1951

Floyd L. Jensen RLS
County Surveyor