2470

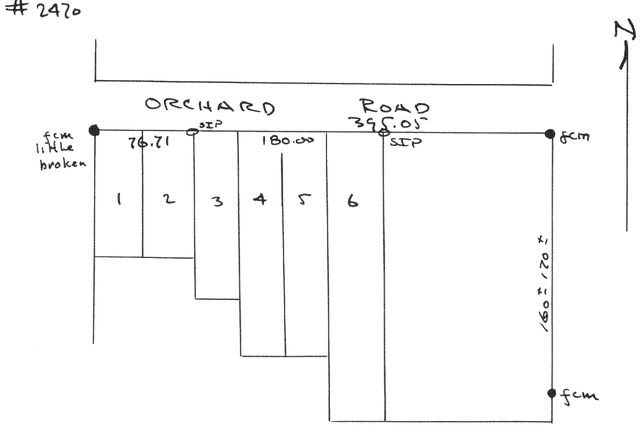

Plat of survey of the North line of lots 3-6
Block 37 of Interlaken Subdivisions located in Sec. 11 T3N R16E
of Walworth County, Wisconsin
July 23, 1951

Lloyd L. Jensen PLS
County Surveyor

2471

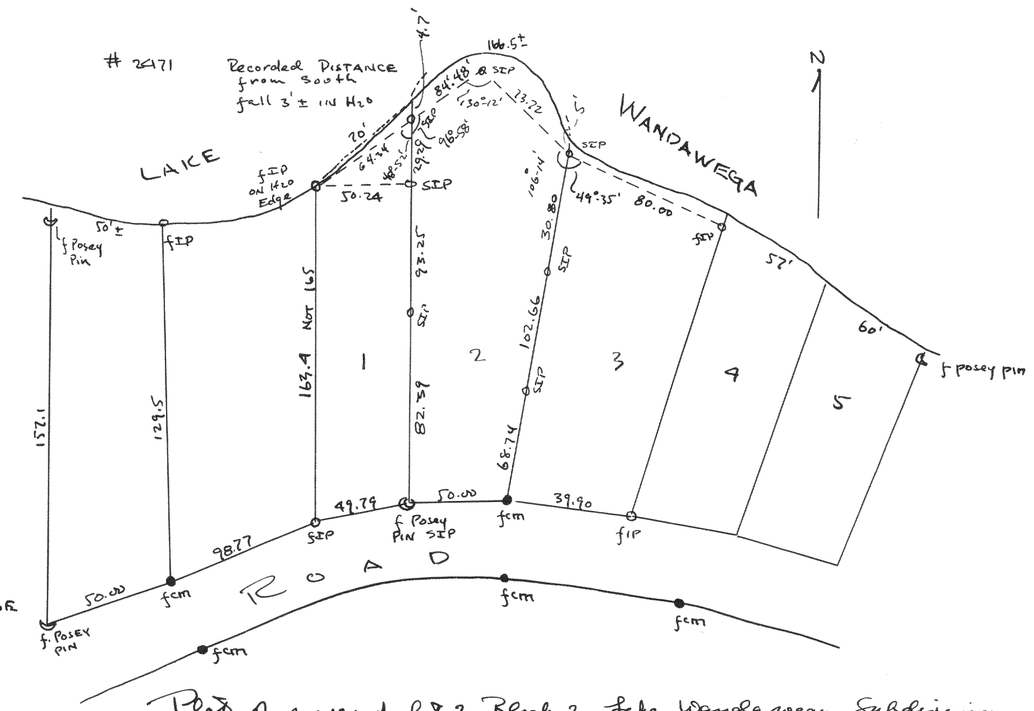

Plat of survey of lot 2, Block 2, Lake Wandawega Subdivision
located in Section 12, T3N R16E Walworth County, Wisconsin
Aug 22, 1951

Lloyd L. Jensen PLS
County Surveyor

2472

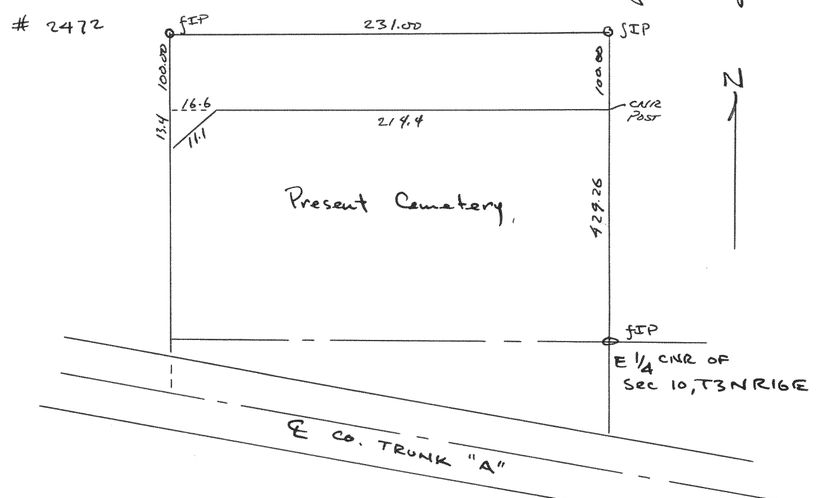

Plat of survey of 100' strip of land along the North line
of Sugar Creek Cemetery located in Section 10, T3N R16E,
Walworth County, Wisconsin
Sept 12, 1951

Lloyd L. Jensen PLS
County Surveyor