#1936

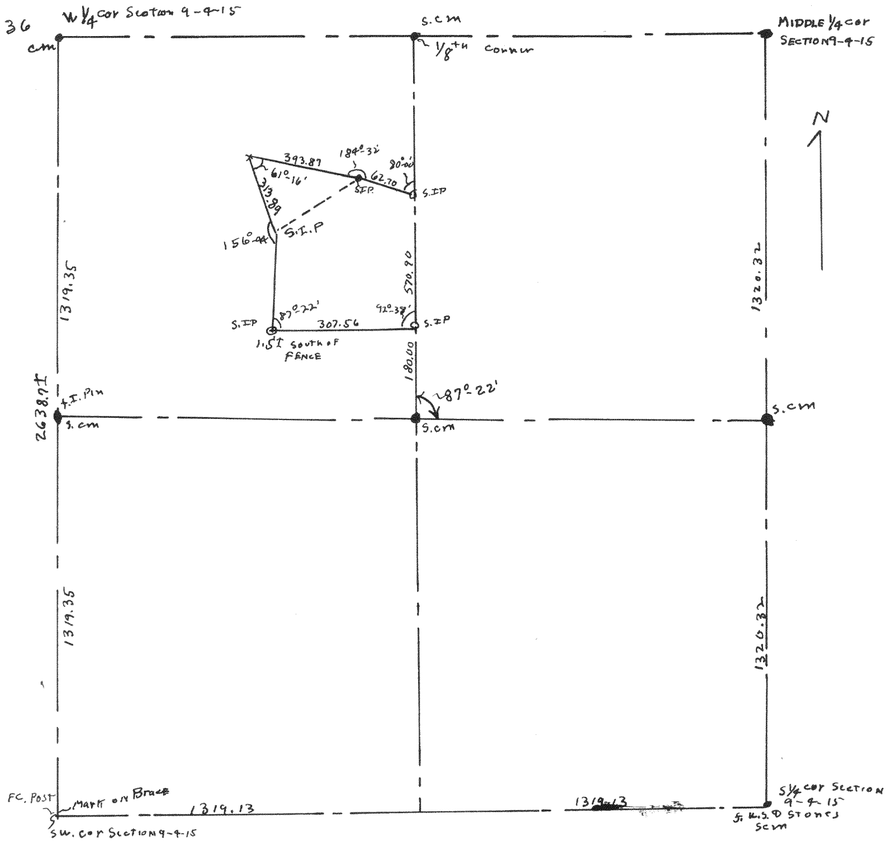

Plat of survey of a parcel of land located in the NW1/4 of the SW1/4 of Section 9 T4N RISE of Walworth County Wisc

June 1998

Lloyd S Jensen
County Surveyor

#1937

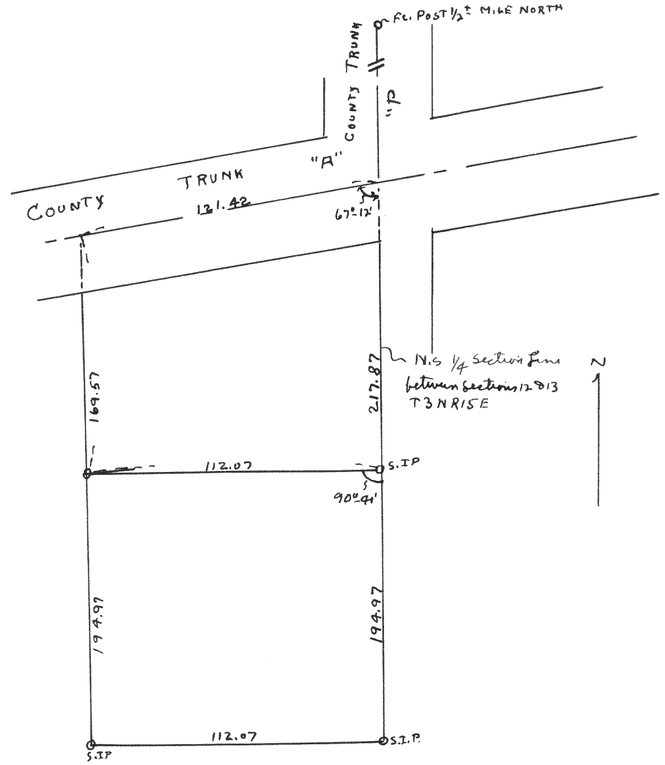

Plat of survey of a parcel of land located in the NE1/4 of Section 13, T3N RISE of Walworth County Wisconsin

December 1998

Lloyd S Jensen
County Surveyor