#2254

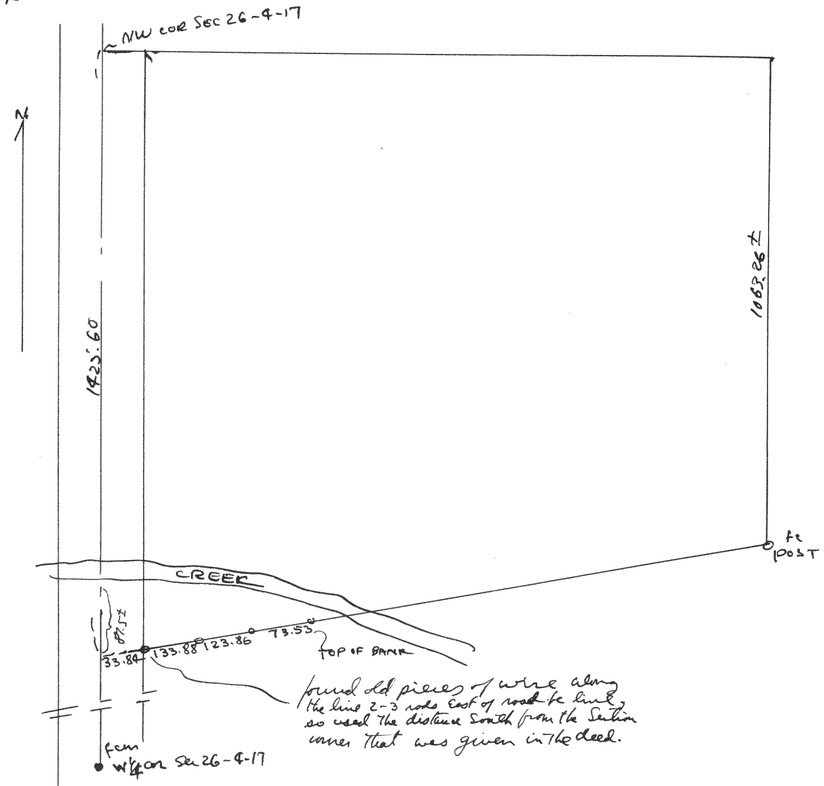

Plat of survey of a portion of the South line of the Flees Farm located in the NW¼ of Sec 26, T4NR17E of Walworth County, Wis.
Nov. 14, 1950

Lloyd J. Jensen
County Surveyor

#2255

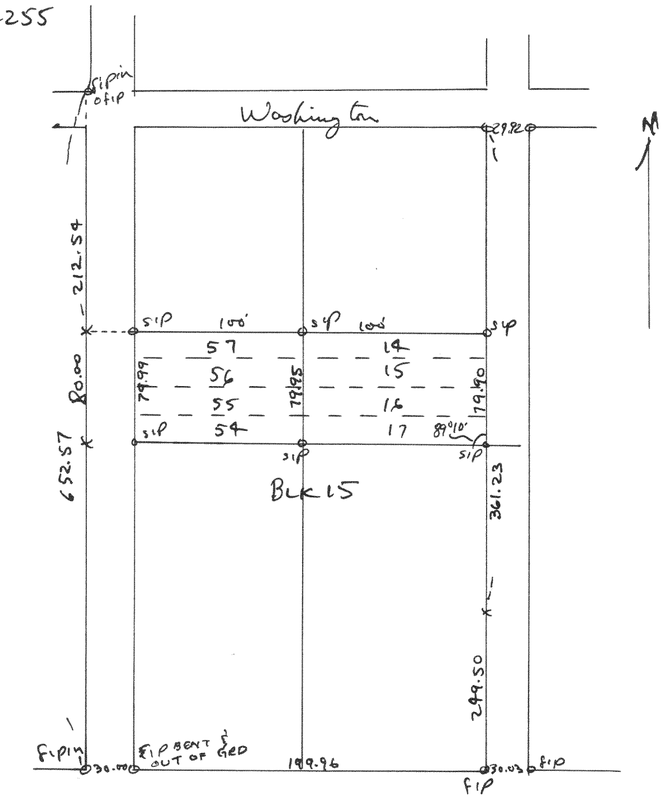

Plat of survey of Lots 14-17, and 54-57 Lake Swanboe located in Sec 2, T1N R18E of Walworth County, Wis.
July 1950

Lloyd J. Jensen
County Surveyor