#2263

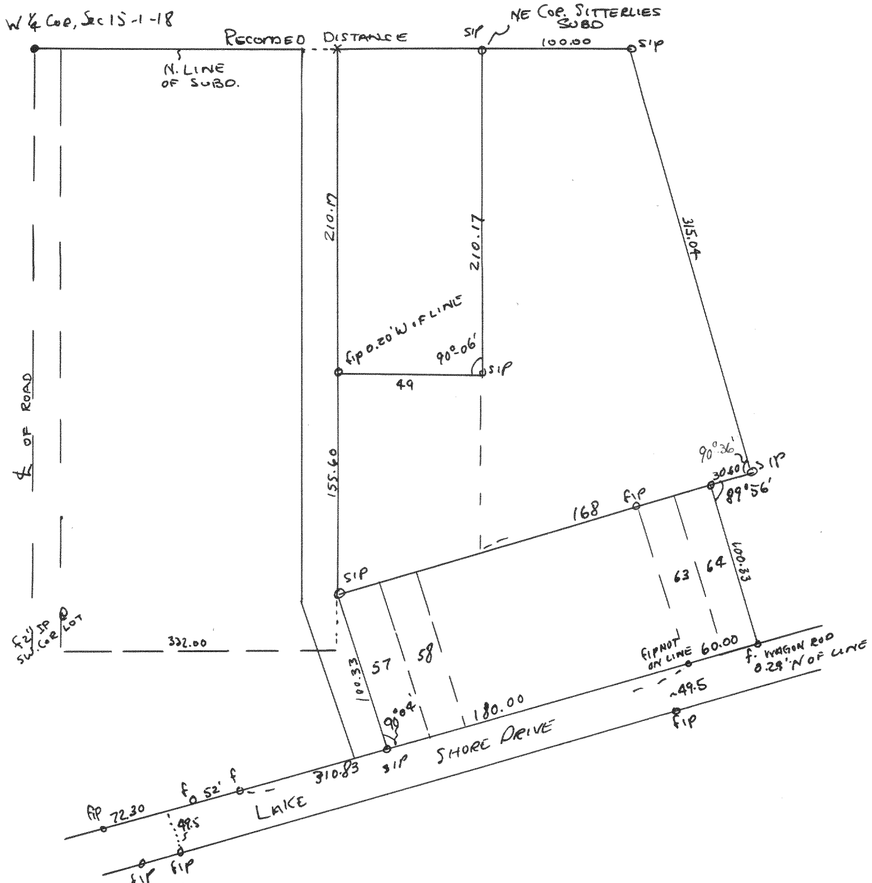

Plat of survey of land owned by the Catholic Church, which includes Lots 49-53, 57-64 of Sitterlies Subd and a parcel of land to Northeast of Subdivision located in SW¼ of Sec 15, T1N R18E of Walworth County, Wisconsin.
Nov 3, 1950

Floyd L. Jensen
County Surveyor

#2264

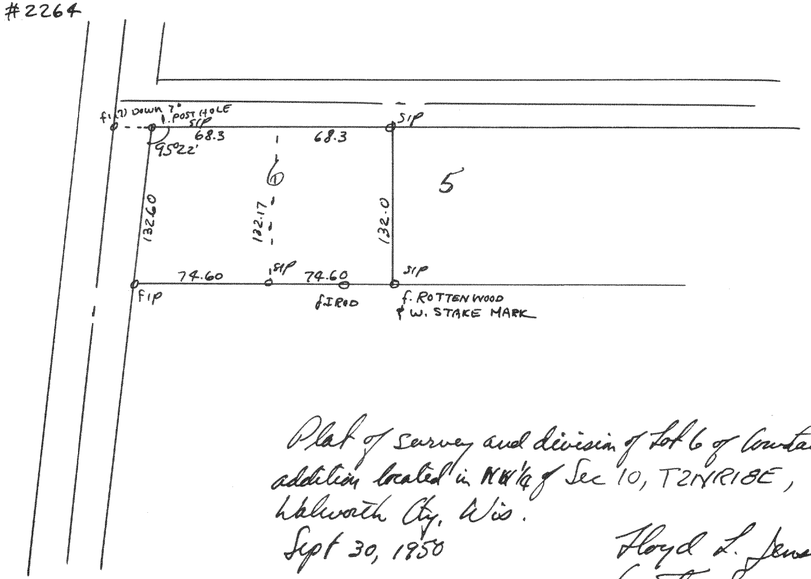

Plat of survey and division of Lot 6 of Contadeo addition located in NW¼ of Sec 10, T2N R18E, Walworth Cty, Wis.
Sept 30, 1950

Floyd L. Jensen
County Surveyor

#2265

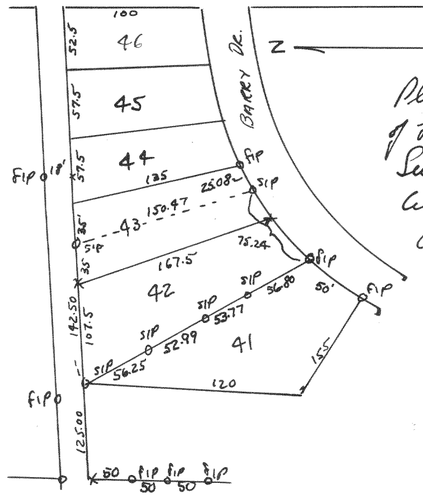

Plat of Survey of Lot 42 & the W½ of Lot 43 of L. Geneva Subd Walworth Subd in Sec 31, T2N R18E, Walworth County, Wis.
Oct 9, 1950

Floyd L. Jensen
County Surveyor