558

#2368

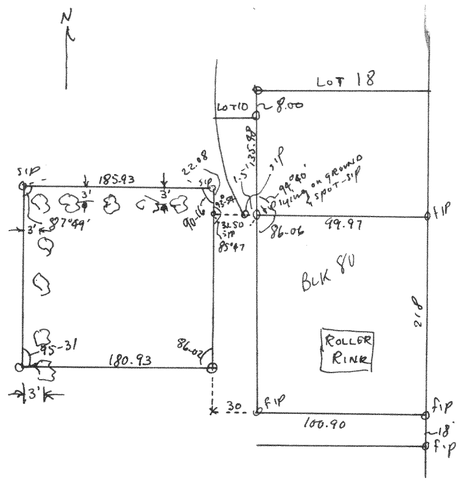

Plat of survey of parcel of land to the West of Blk 80 of Lake Wandawega Subd, Lot Park Add located in the SW¼ of Sec 1, T3N R16E, Walworth Co, Wis.
8/3/50

Lloyd L. Jensen PLS
County Surveyor

2369

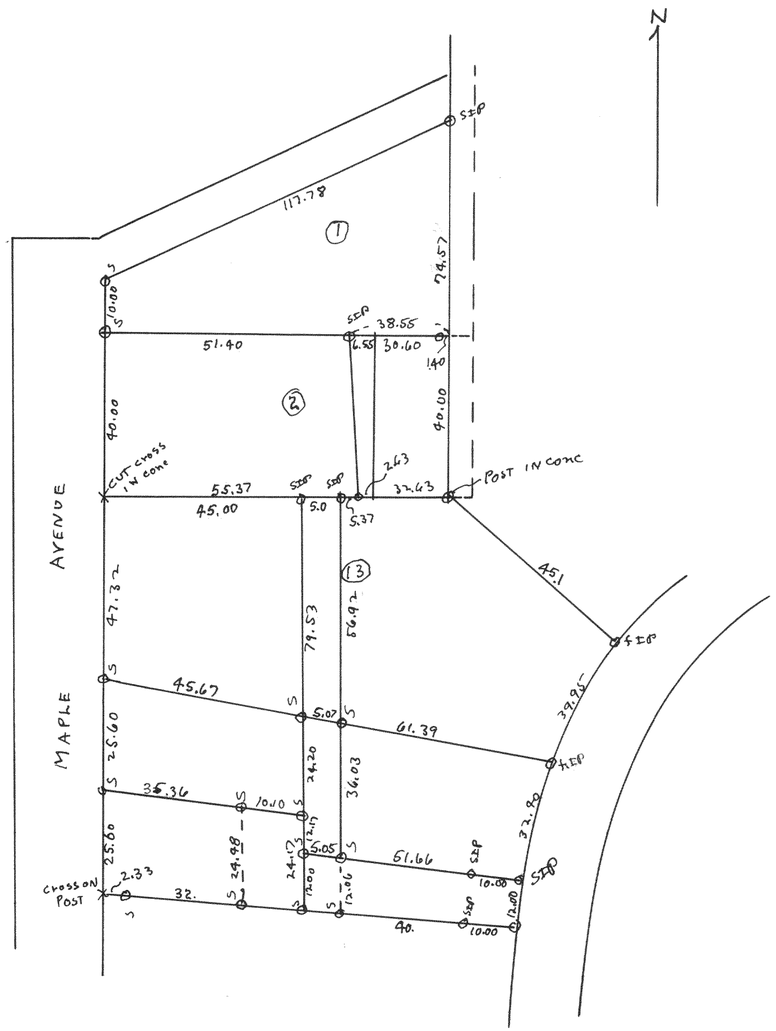

Plat of survey of lots 12 & 13 of Indian Hills Subd & Lot 182 of Glenwood Springs located in the Village of Fontana, Walworth County, Wisconsin
Aug 1950

Lloyd L Jensen PLS
County Surveyor