#588

2451

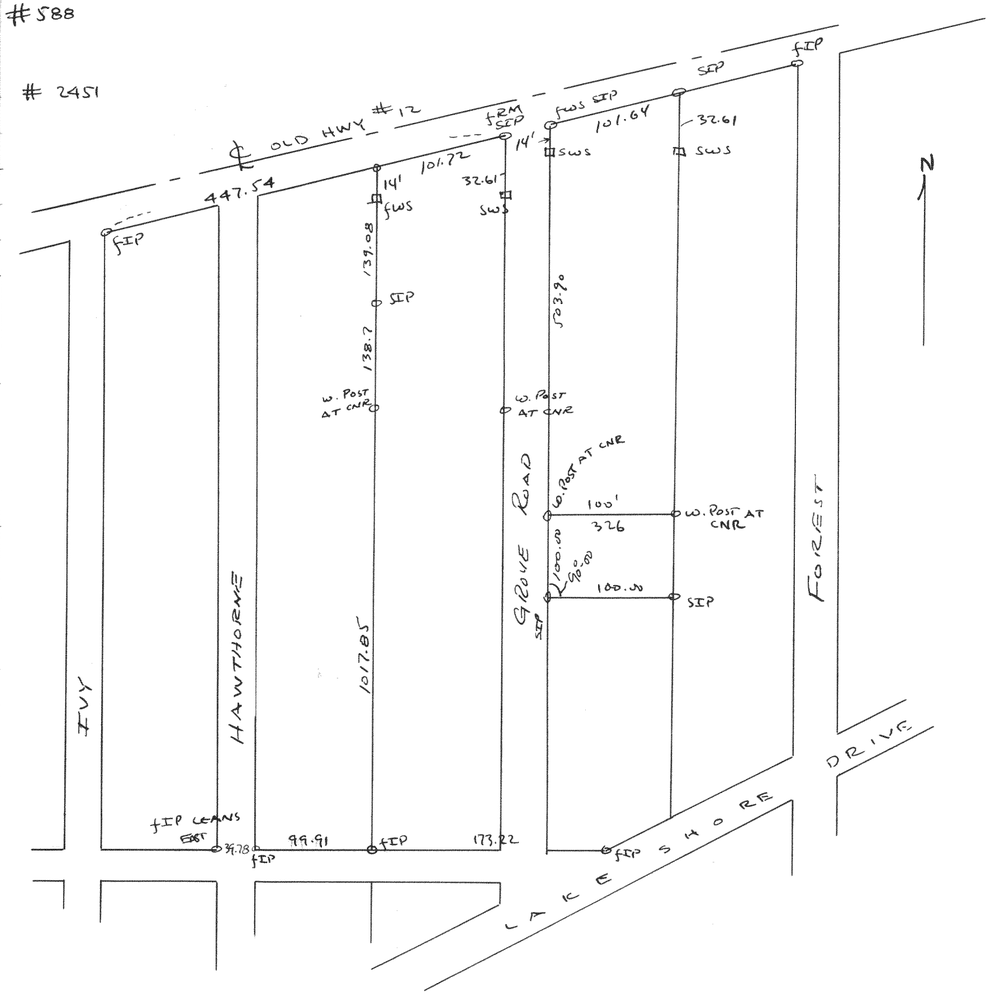



2452

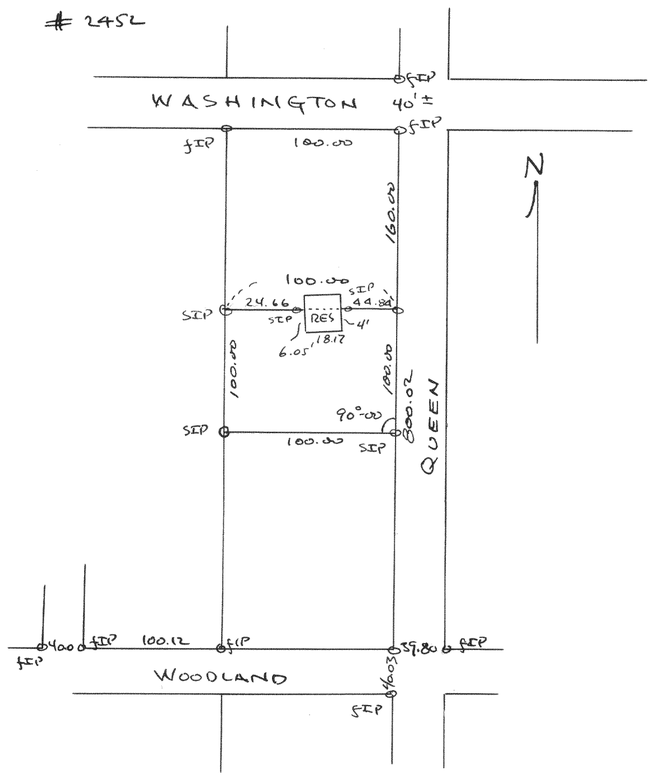


