608

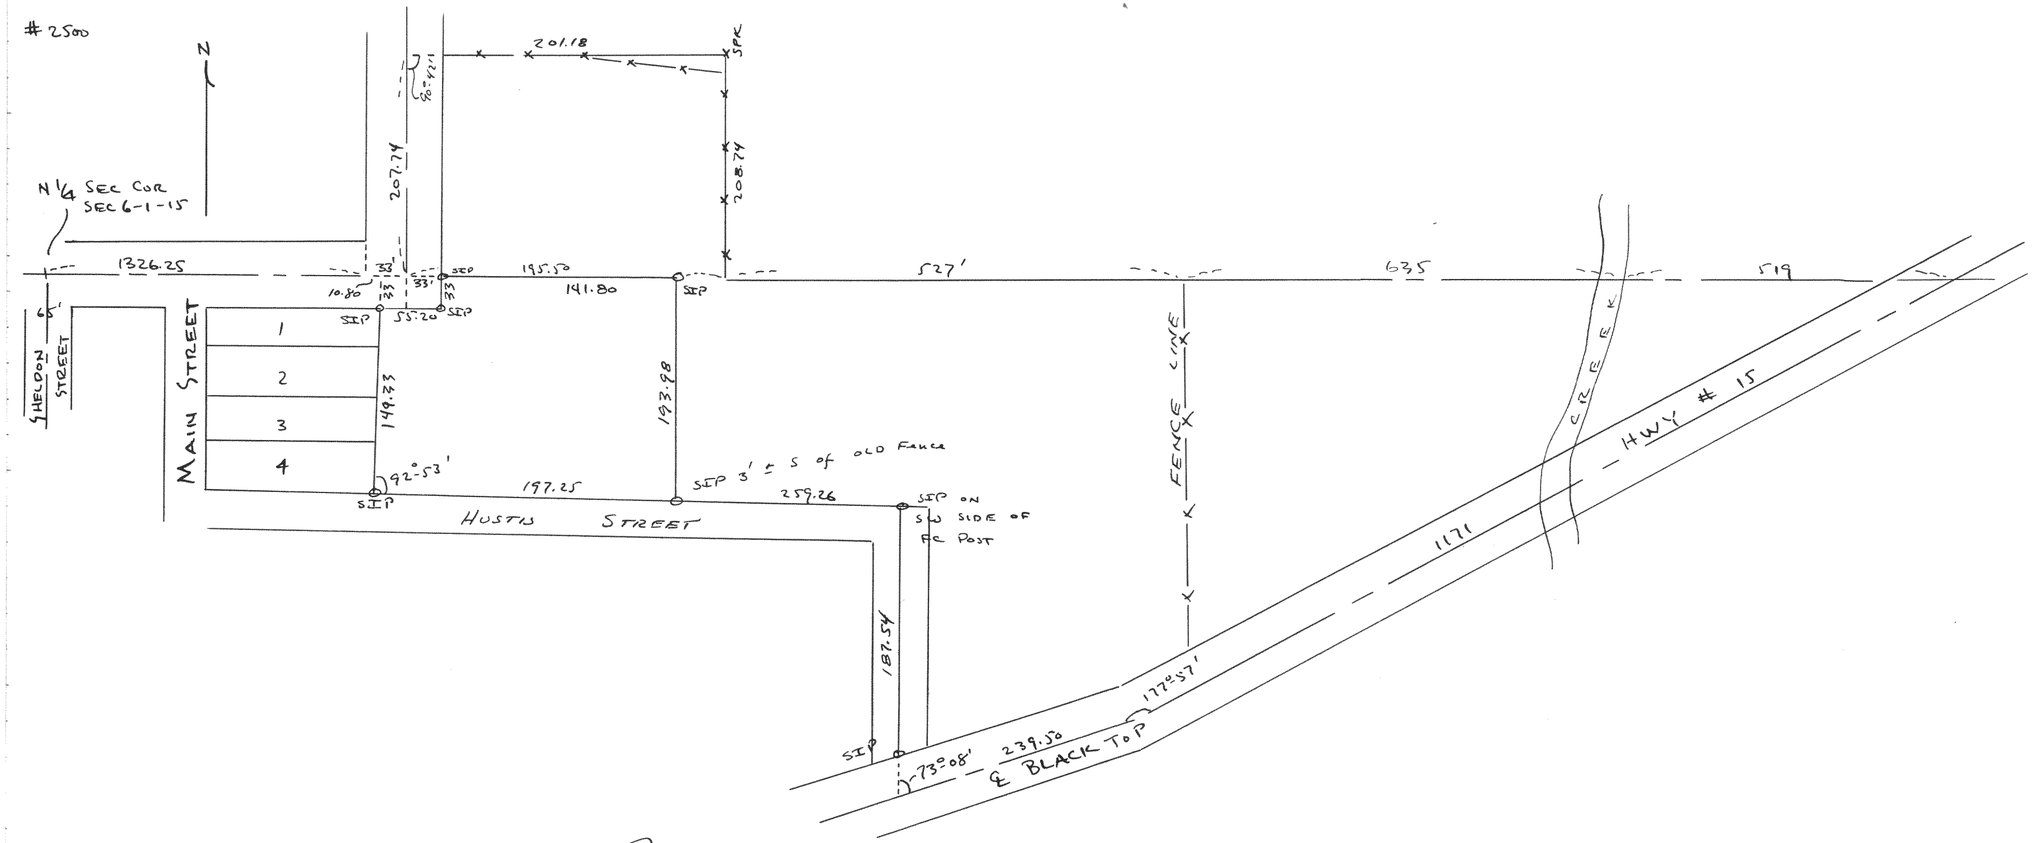

Plat of survey of part of the Huber Estate located in Sec 6, T1N R15E & Sec. 31, T2N R15E of Walworth County, Wisconsin
April 3, 1951

Lloyd L. Jensen RES
County Surveyor