#3679

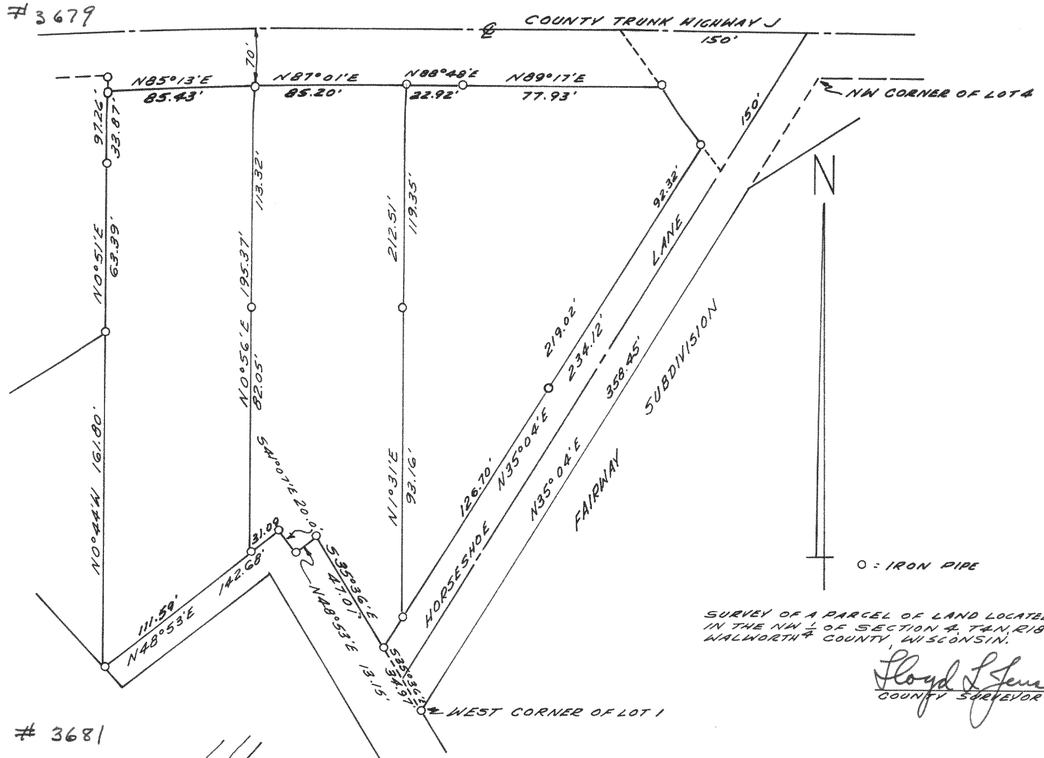

SURVEY OF A PARCEL OF LAND LOCATED IN THE NW ¼ OF SECTION 4, T4N, R18E. WALWORTH COUNTY, WISCONSIN.

Floyd L Jensen
COUNTY SURVEYOR

#3680

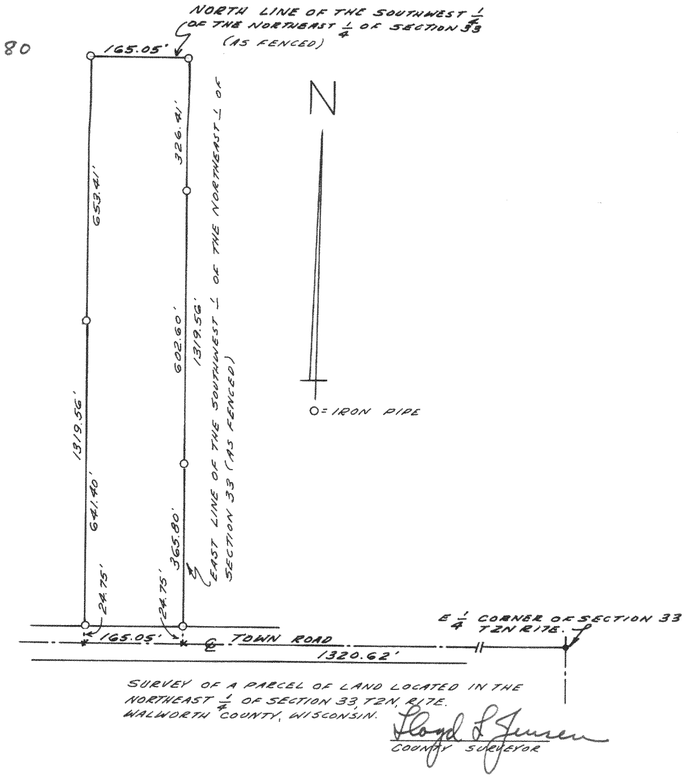

SURVEY OF A PARCEL OF LAND LOCATED IN THE NORTHEAST ¼ OF SECTION 33, T2N, R17E. WALWORTH COUNTY, WISCONSIN.

Floyd L Jensen
COUNTY SURVEYOR

#3681

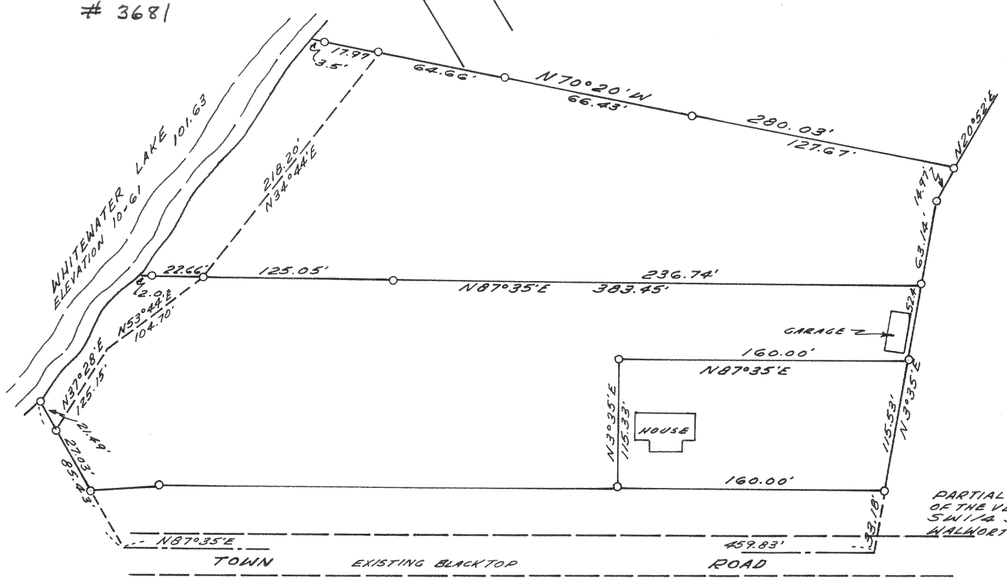

PARTIAL MAP OF CONTOURS OF THE VENCA PROPERTY IN SW¼ SECTION 35, T4N, R18E. WALWORTH COUNTY, WISCONSIN.

Floyd L Jensen
COUNTY SURVEYOR

#3682

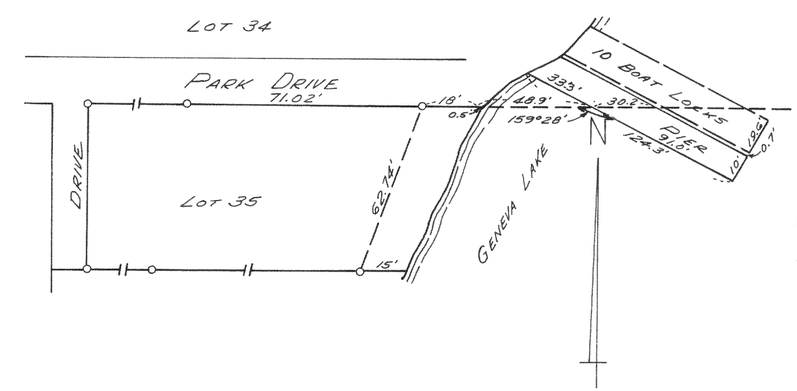

SURVEY OF AREA ADJACENT TO LOT 35 LOCH VISTA CLUB, VILLAGE OF WILLIAMS BAY, WALWORTH COUNTY, WISCONSIN.

Floyd L Jensen
COUNTY SURVEYOR