#3834

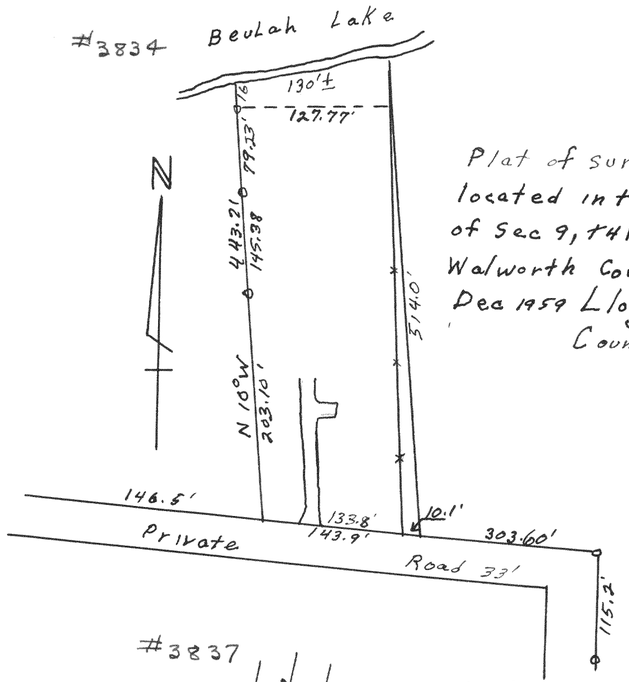


Plat of survey of land located in the NE ¼ of Sec 9, T4N, R 18 E of Walworth County Wisconsin Dec 1959 Lloyd L. Jensen County Surveyor

#3835

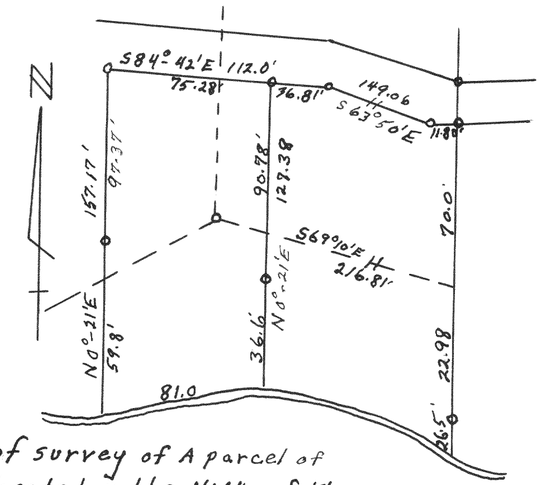


Plat of survey of A parcel of land located in the N.W.¼ of the NE ¼ of Sec 30, T4N, R18 E Village of East Troy Walworth County Wisconsin Feb 1959 Lloyd L. Jensen County Surveyor

#3836

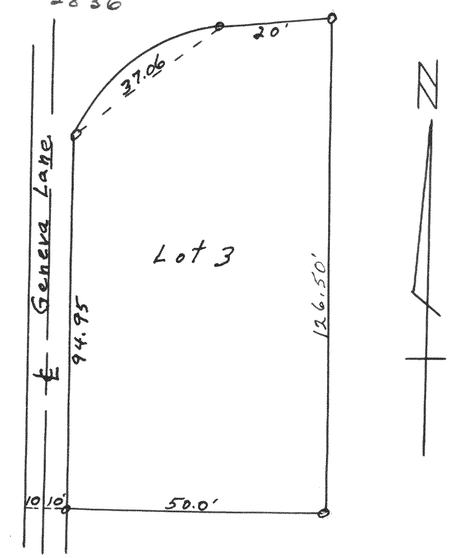


Plat of survey of Lot 3 of Indian Hills 1st Addition Lloyd L. Jensen June. 1959 County Surveyor

#3837

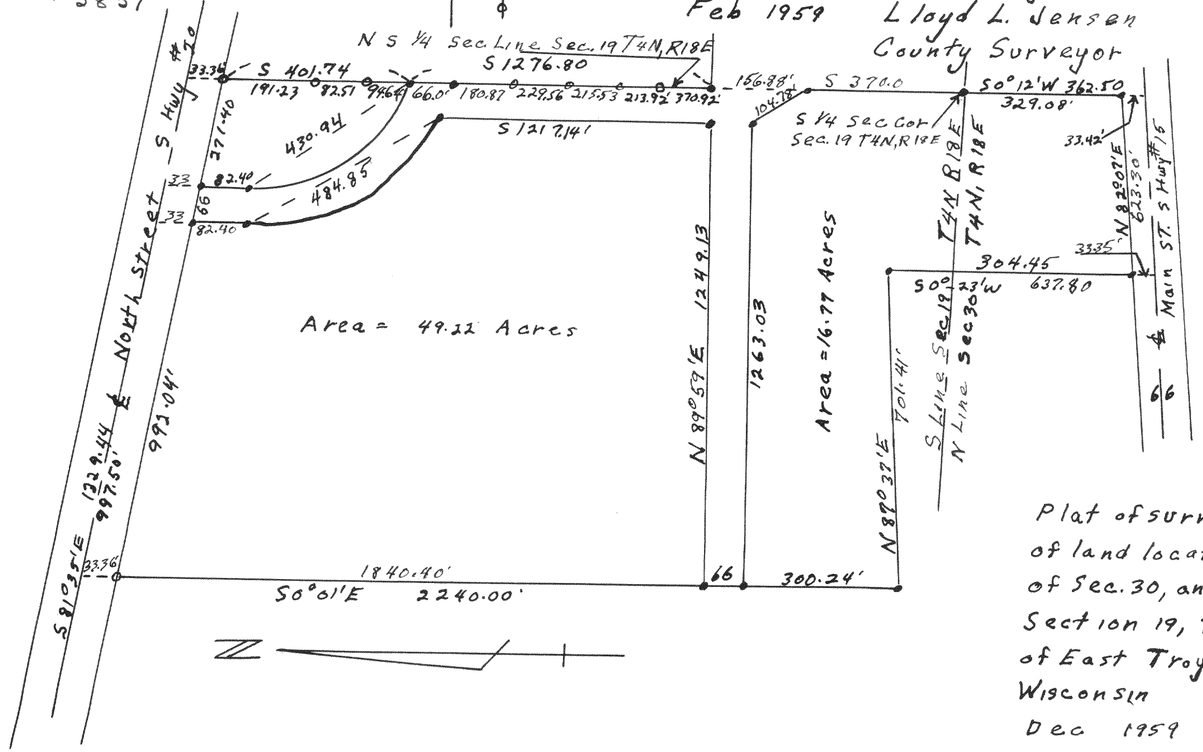


Plat of survey of a parcel of land located in the NW ¼ of Sec. 30, and The S.W. ¼ of Section 19, T4N, R18E Village of East Troy Walworth County Wisconsin Dec 1959 Lloyd L. Jensen County Surveyor