#3846

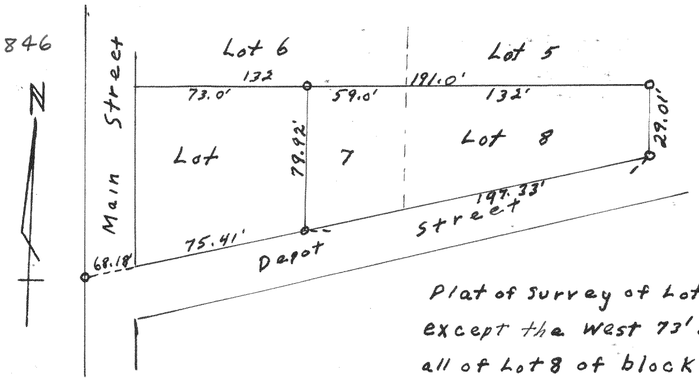

Plat of Survey of Lot 7 except the west 73' and all of Lot 8 of block 27 of Springfield T2N, R18E Walworth County Wisconsin Sep. 1959 Lloyd L. Jensen County Surveyor

#3847

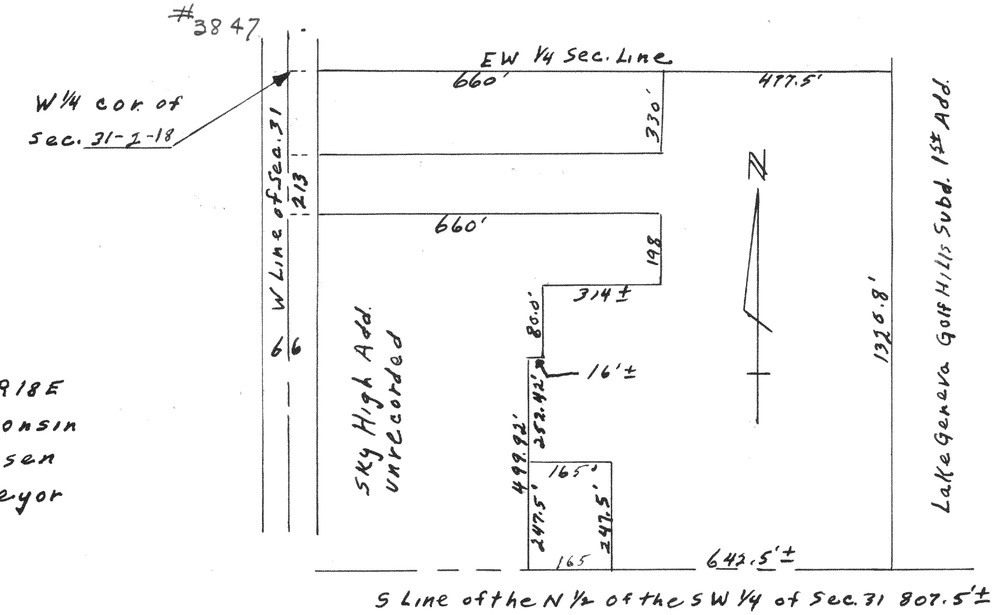

#3848

Plat of Survey of Part of Lots 3 and 4, Block 12, original plat of the Village of East Troy Walworth County Wisconsin May 1959 Lloyd L. Jensen County Surveyor

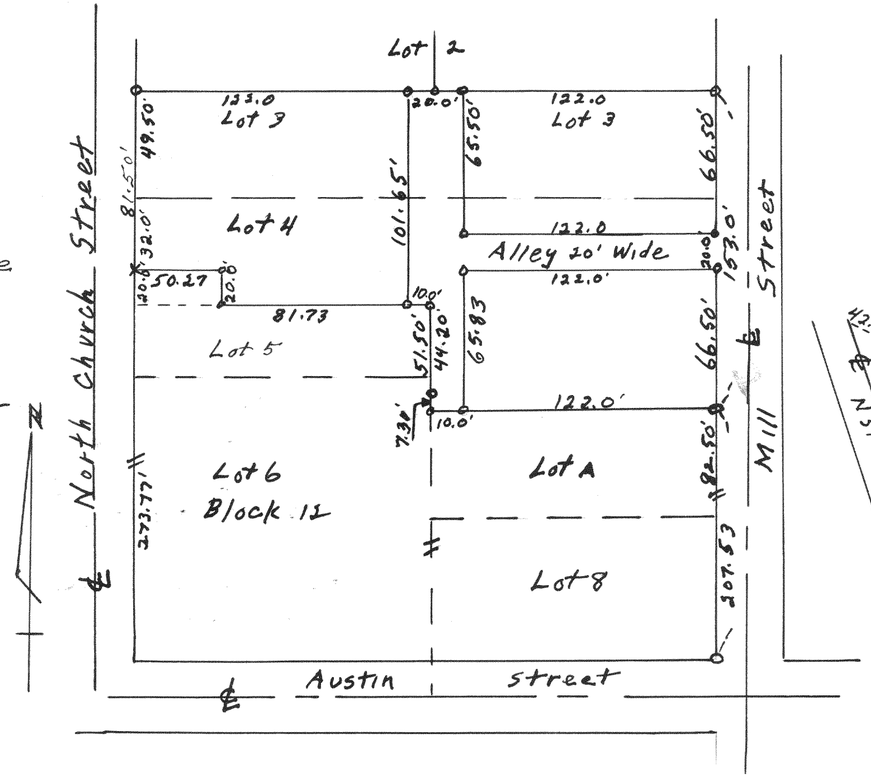


#3849

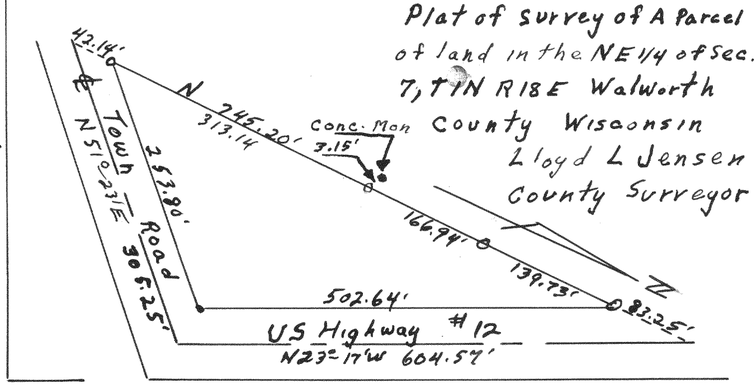

Plat of survey of A Parcel of land in the NE 1/4 of Sec. 7, T1N R18E Walworth County Wisconsin Lloyd L Jensen County Surveyor