#4146

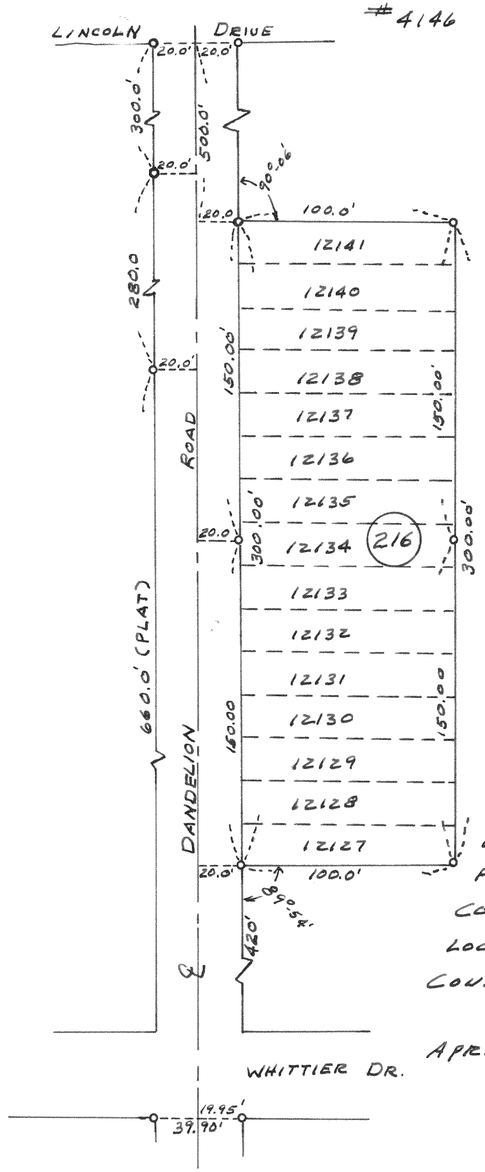

PLAT OF SURVEY OF Lots 12127 to 12141 OF THE FIFTH MAP OF LAKE COMO BEACH A SUBDIVISION LOCATED IN WALWORTH COUNTY, WISCONSIN

APRIL 19, 1963

Floyd L. Jensen
COUNTY SURVEYOR

#4147

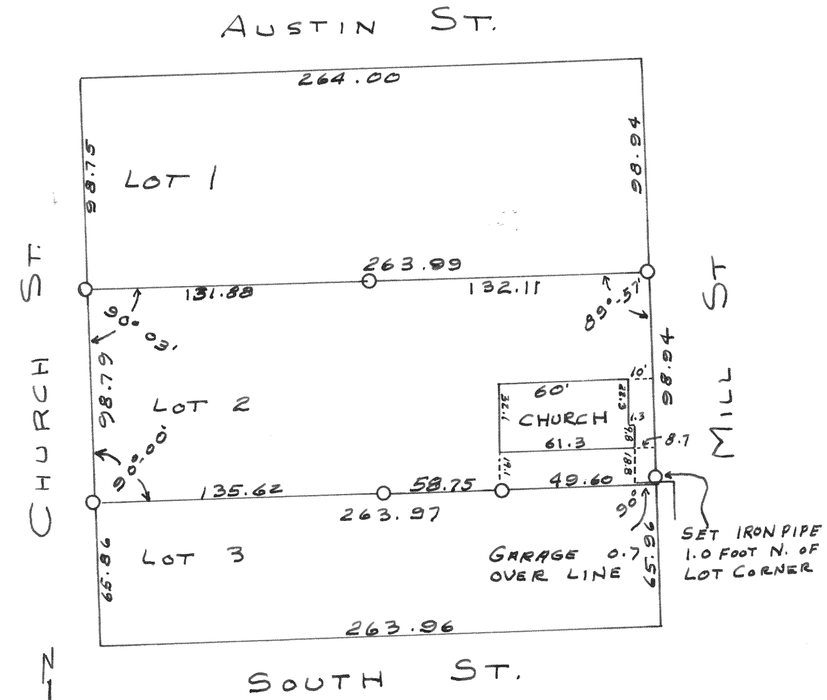

PLAT OF SURVEY OF LOTS OF BLOCK 15 OF THE ORIGINAL PLAT OF THE VILLAGE OF EAST TROY, WALWORTH COUNTY, WISCONSIN

DEC. 1963

Floyd L. Jensen
COUNTY SURVEYOR