2875

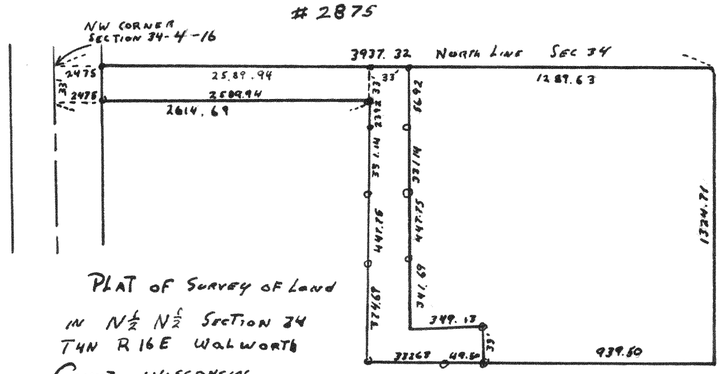

PLAT of Survey of Land
IN N½ N½ SECTION 34
T4N R16E Walworth
County Wisconsin
March 1954 Lloyd L Jensen

2876

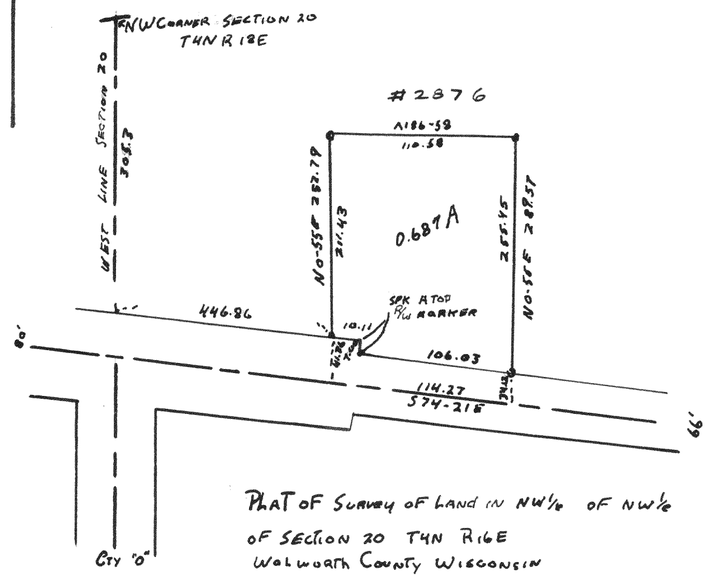

PLAT OF SURVEY OF LAND IN NW¼ OF NW¼
OF SECTION 20 T4N R18E
Walworth County Wisconsin
DEC 1954 Lloyd L JENSEN

2877

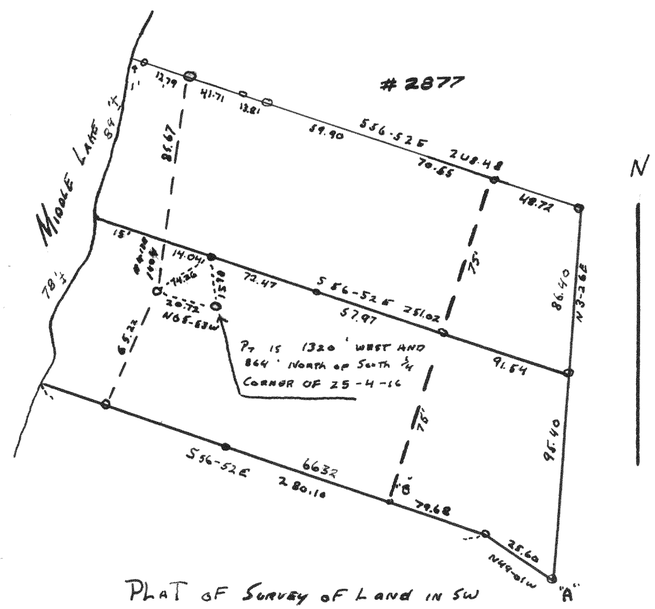

PLAT OF SURVEY OF LAND IN SW
FR ¼ SECTION 25 T4N R18E
Walworth County Wisconsin
Aug 1954 Lloyd L JENSEN

2878

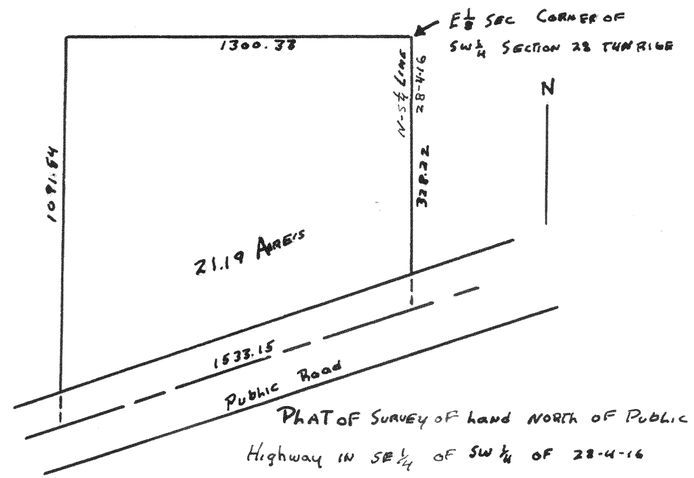

PLAT OF SURVEY OF land NORTH OF PUBLIC
Highway IN SE¼ OF SW¼ OF 28-4-16
Walworth County Wisconsin
DEC 1954 Lloyd L JENSEN

2879
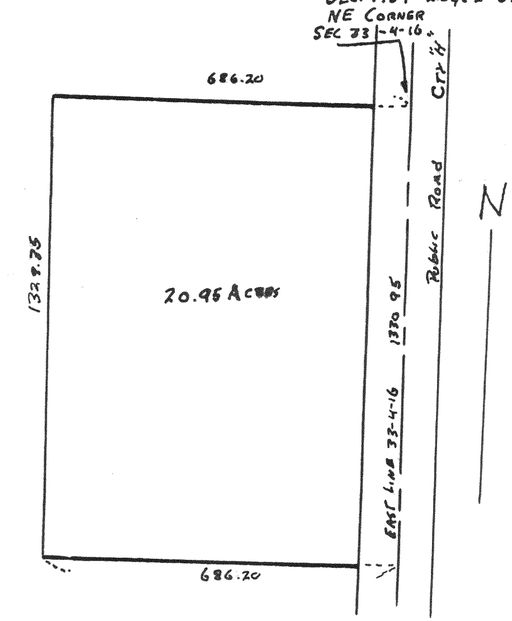
PLAT OF SURVEY OF PART OF NE¼ OF NE¼
SECTION 33 T4N R16E Walworth
County Wisconsin
DEC. 1954 Lloyd L JENSEN