#4664

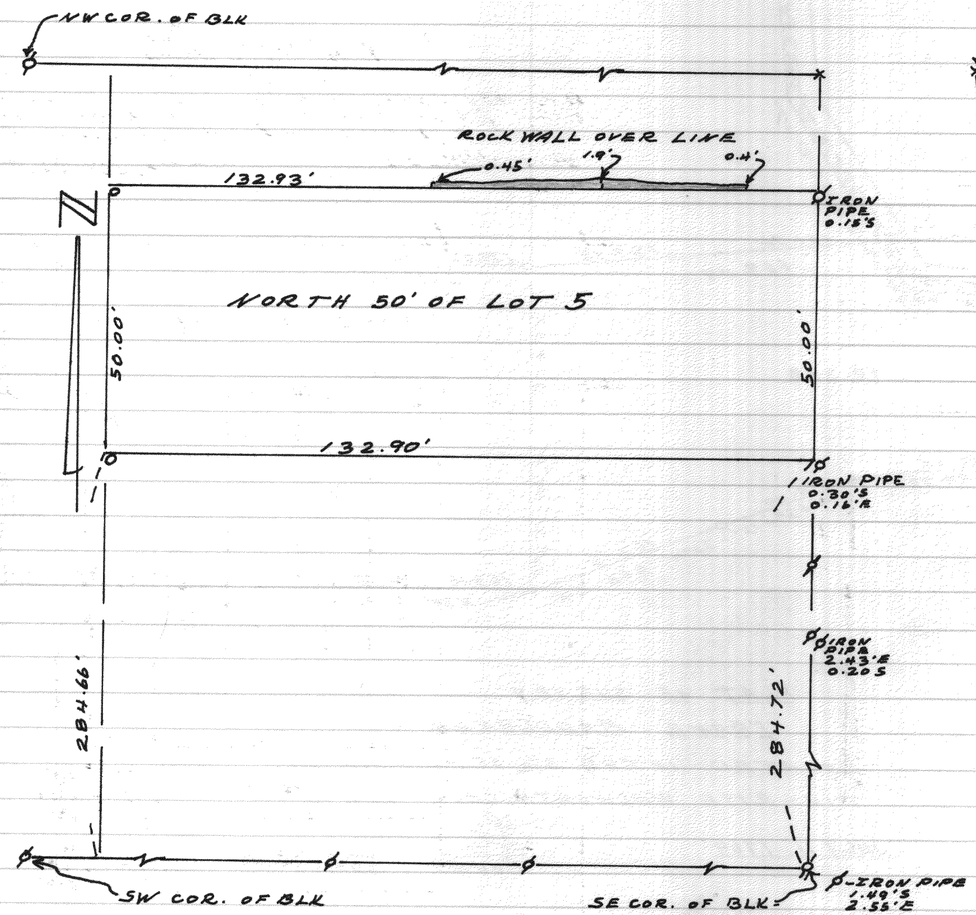


PLAT OF SURVEY

OF

THE NORTH 50.00' OF LOT 5, BLOCK 8,
ORIGINAL PLAT CITY OF ELKHORN, WISC.

JUNE 1969

Floyd L Jensen
SURVEYOR

#4665

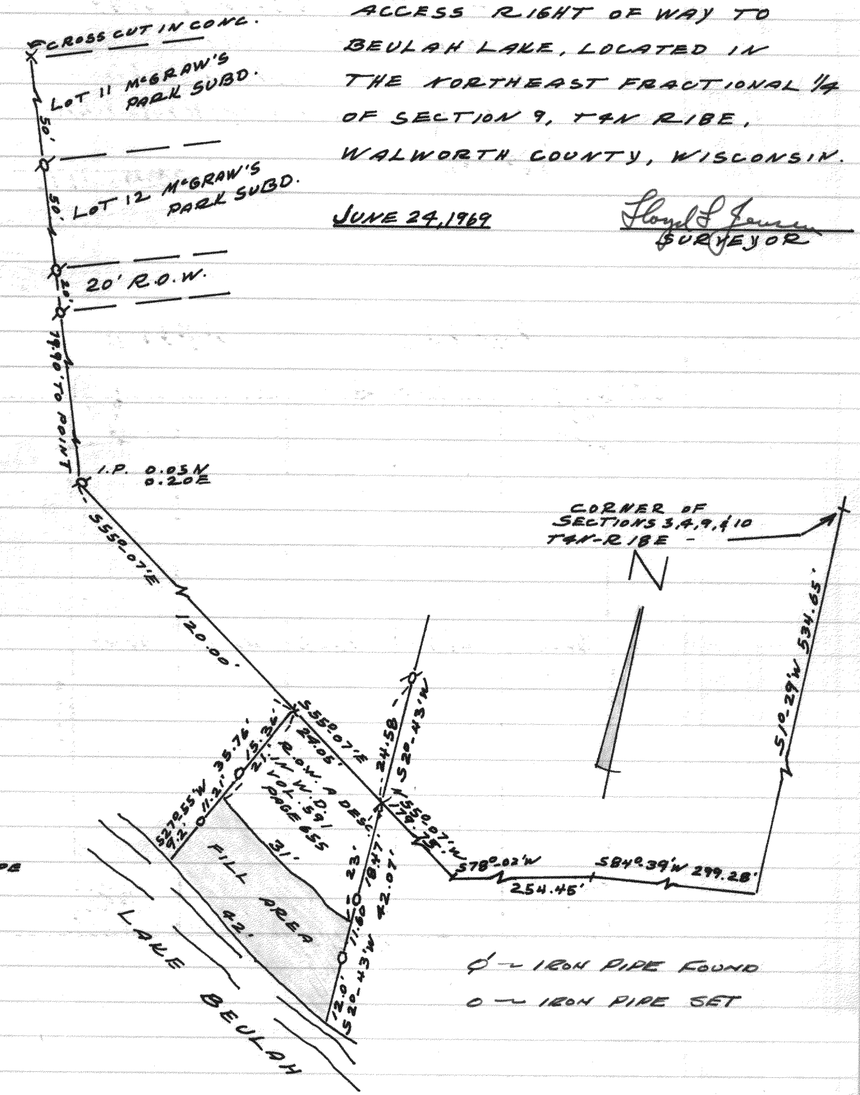


PLAT OF SURVEY

OF

ACCESS RIGHT OF WAY TO
BEULAH LAKE, LOCATED IN
THE NORTHEAST FRACTIONAL 1/4
OF SECTION 9, T4N R18E,
WALWORTH COUNTY, WISCONSIN.

JUNE 24, 1969

Floyd L Jensen
SURVEYOR