PLAT OF SURVEY
OF
THE ISLAND OFF SHORE FROM
TRINKE ESTATES IN THE SE PR'
L 1/4 OF SEC. 10, T1N R17E
WALWORTH COUNTY, WISCONSIN.

NOV. 1967

Floyd P. Jensen
COUNTY SURVEYOR
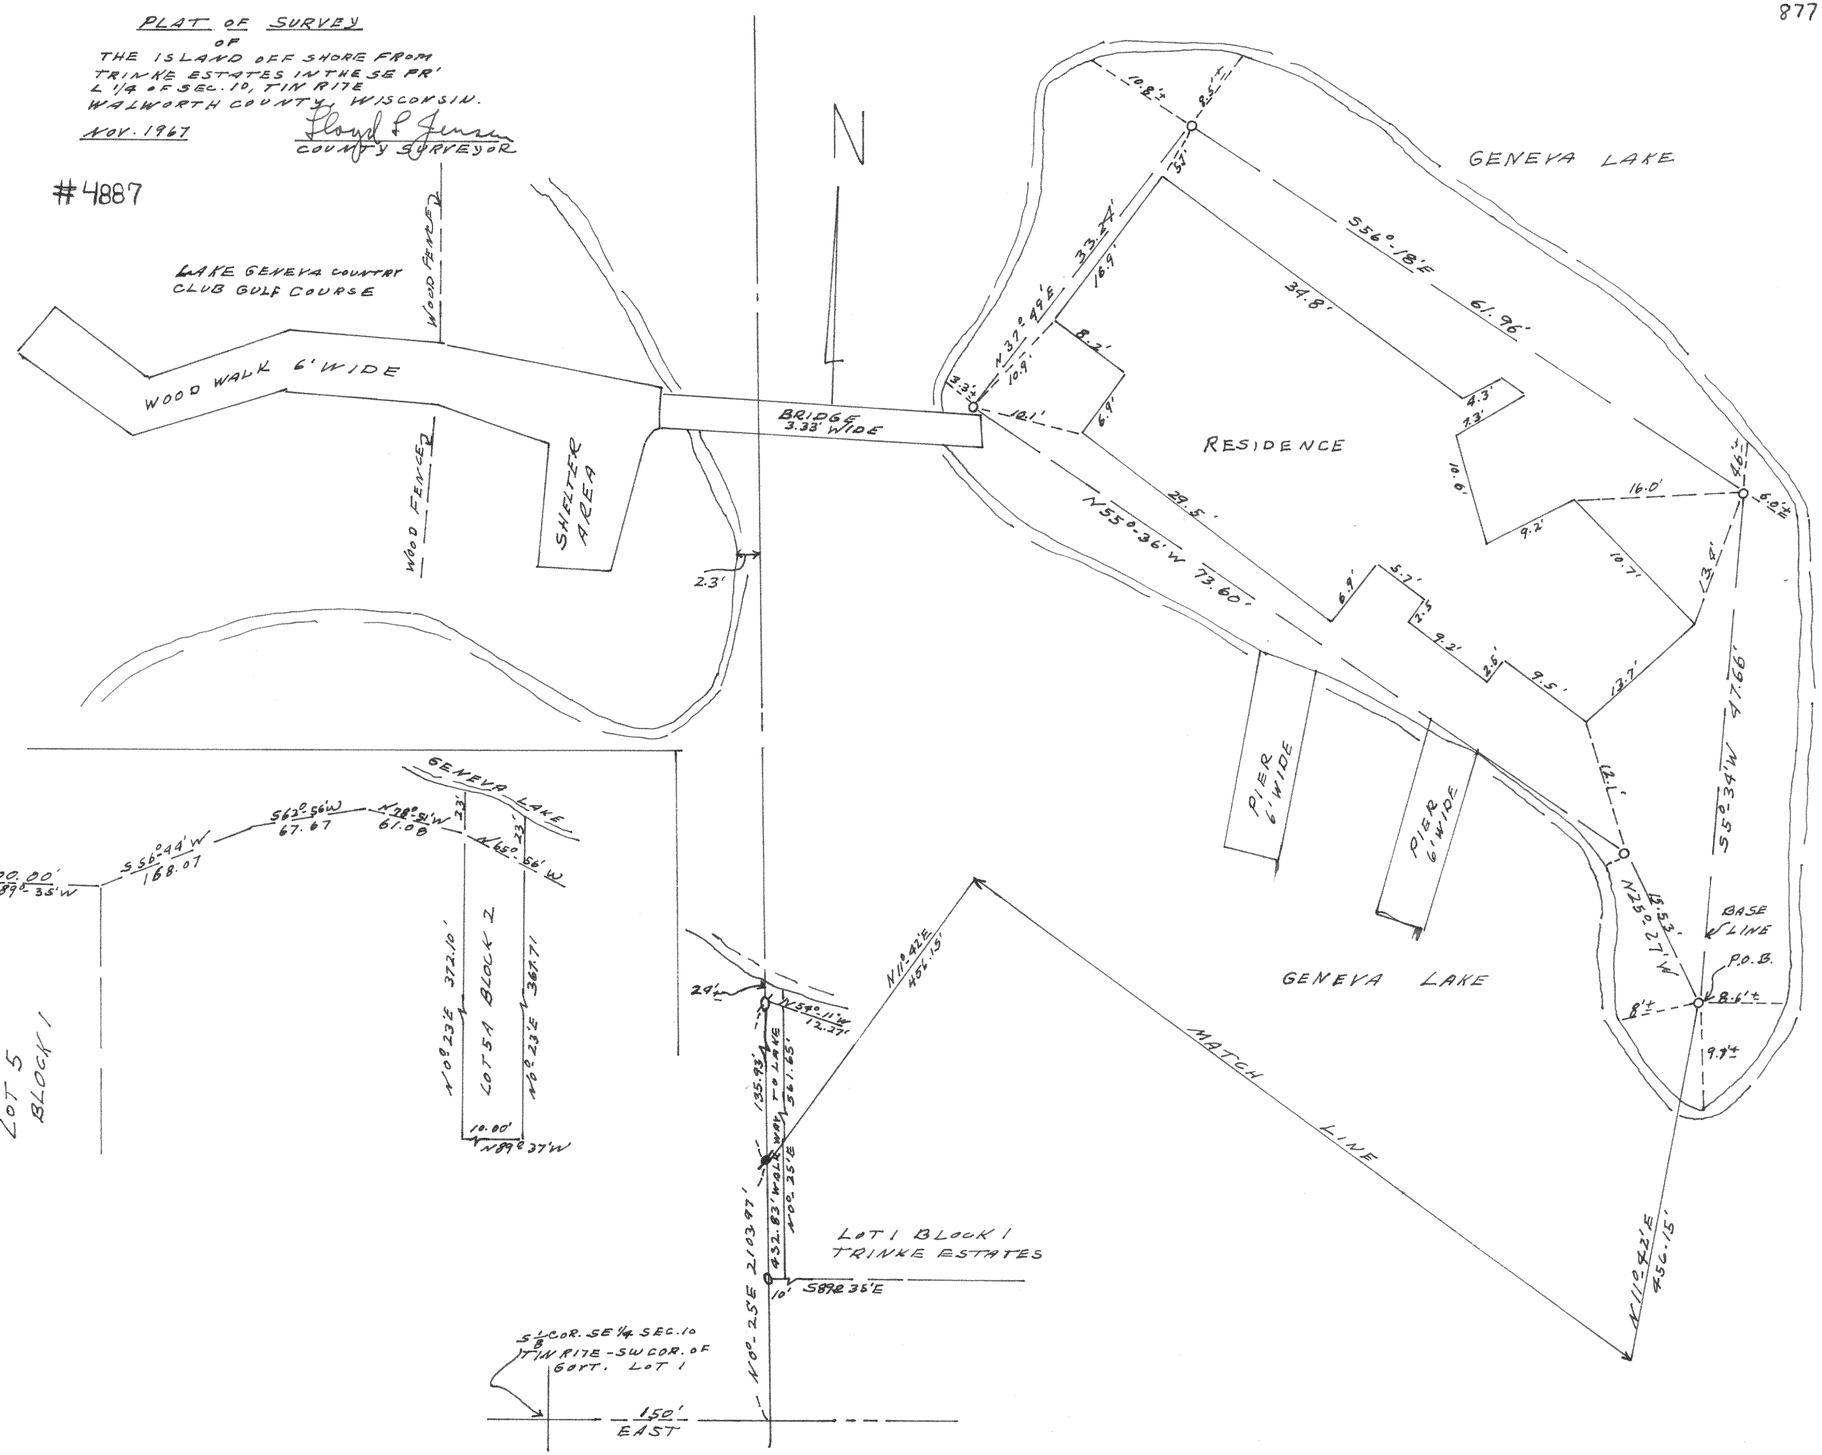
#4887