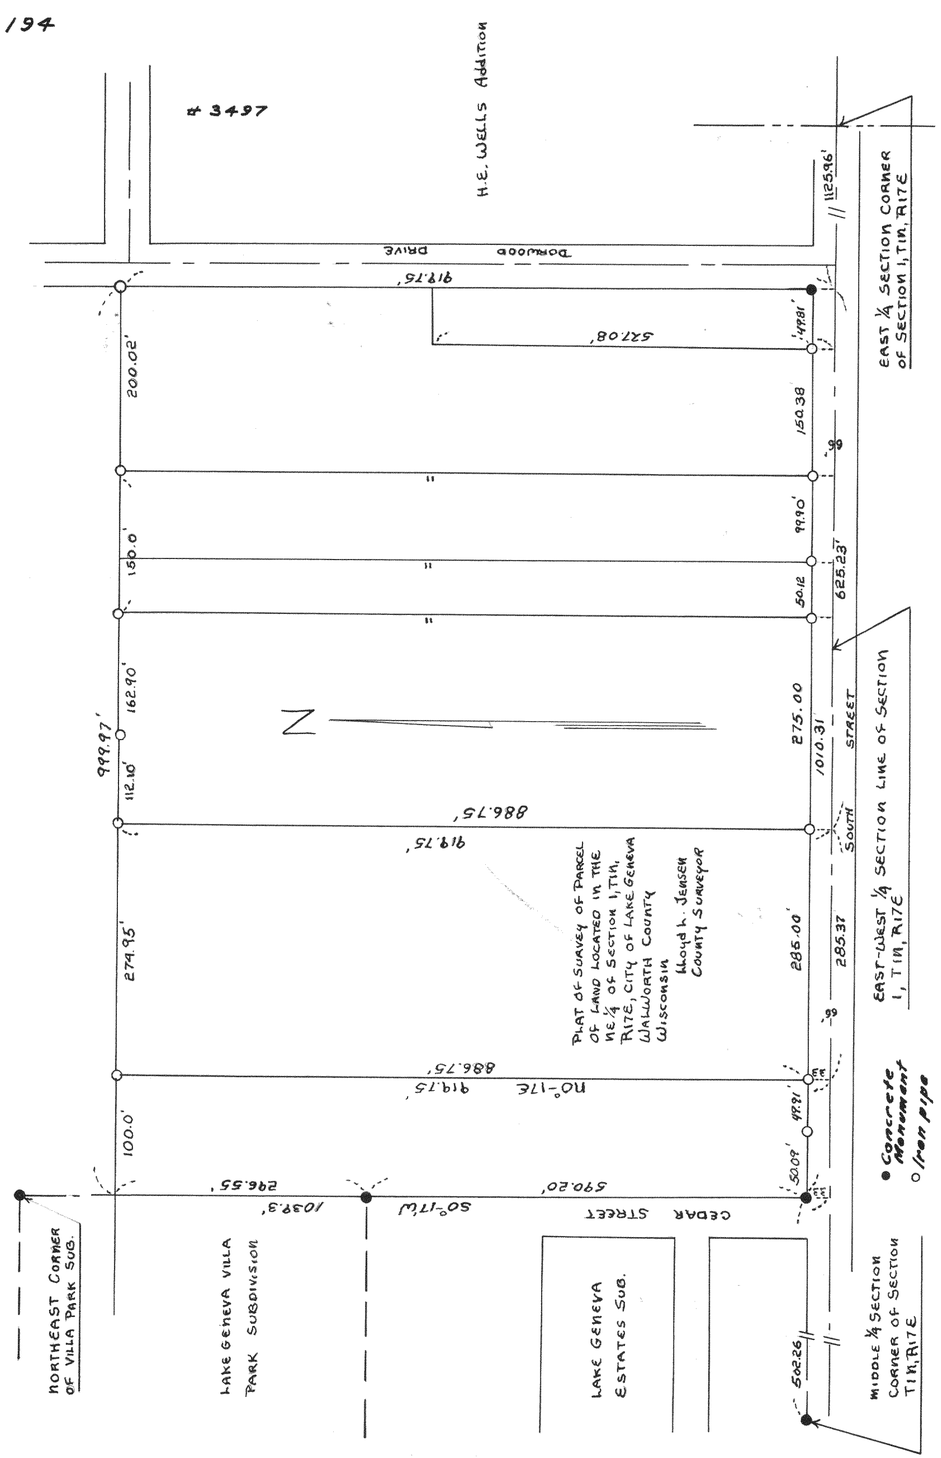

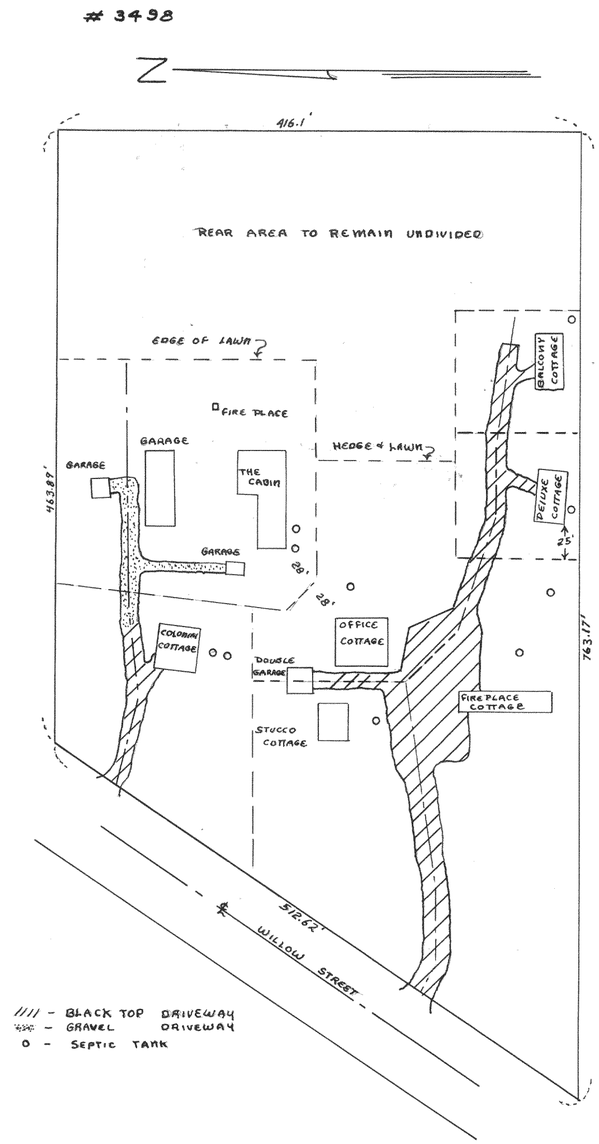

PLAT OF LAND LOCATED IN THE NORTHEAST ¼ OF SECTION 1, T1N R17E, CITY OF LAKE GENEVA, WALWORTH COUNTY, WISCONSIN

PROPOSED DIVISION OF PROPERTY AND RIGHT OF WAYS

Lloyd L. Jensen
County Surveyor