3534

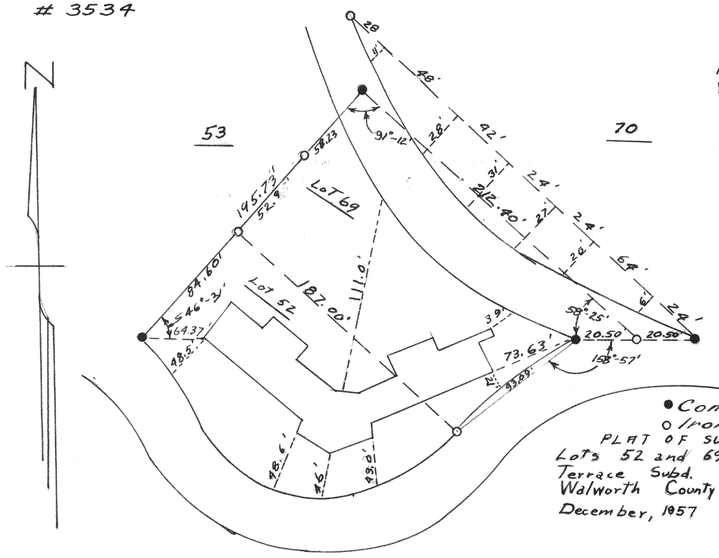

● Concrete monument
○ Iron pipe

PLAT OF SURVEY OF
Lots 52 and 69 of Grand Terrace Subd. Village of Williams Bay
Walworth County, Wisconsin
December, 1957 Lloyd L. Jensen
County Surveyor

3535

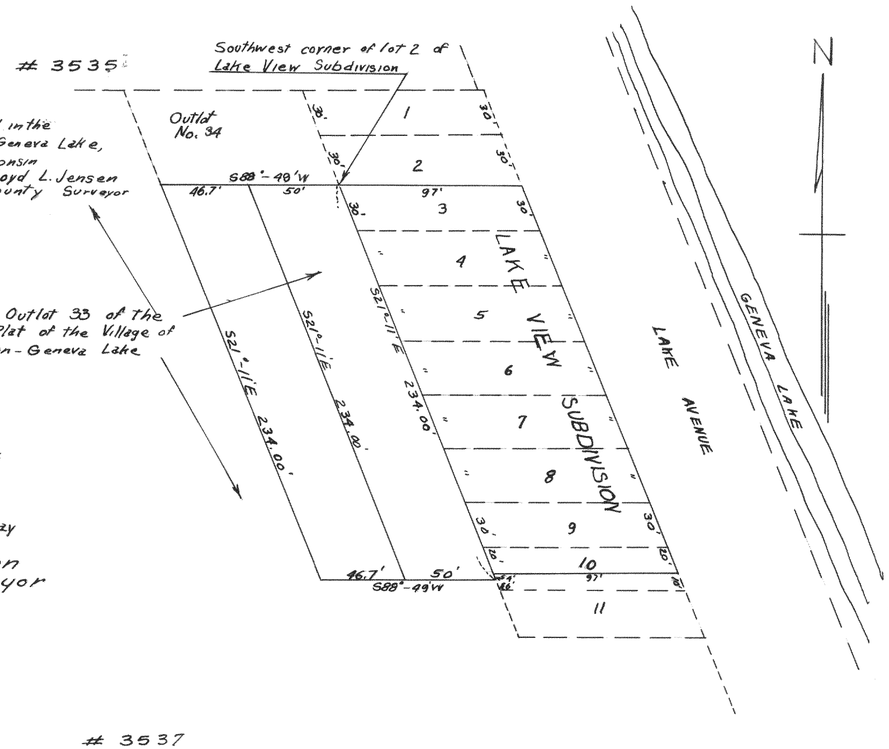

Plat of Survey of land in the Village of Fontana-on-Geneva Lake, Walworth County, Wisconsin
May, 1957 Lloyd L. Jensen
County Surveyor

Part of Outlot 33 of the Assesor's Plat of the Village of Fontana-on-Geneva Lake

3536

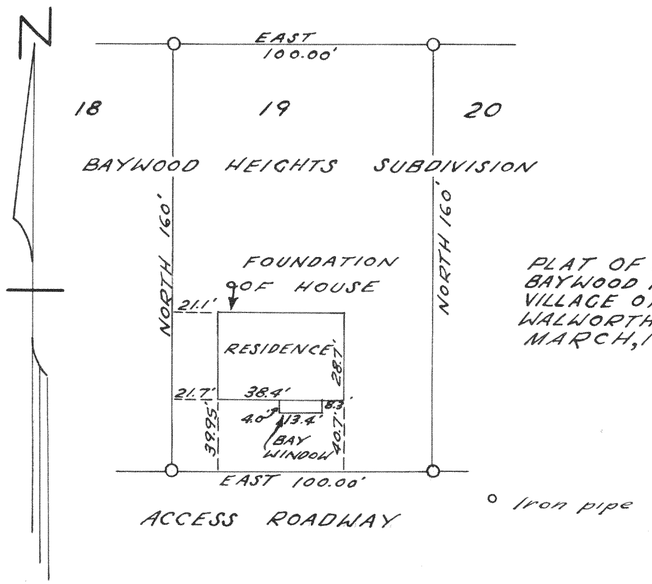

○ Iron pipe

PLAT OF SURVEY OF LOT 19 OF BAYWOOD HEIGHTS SUBD. IN THE VILLAGE OF WILLIAMS BAY WALWORTH COUNTY, WISCONSIN.
MARCH, 1958. Lloyd L. Jensen
County Surveyor

3537

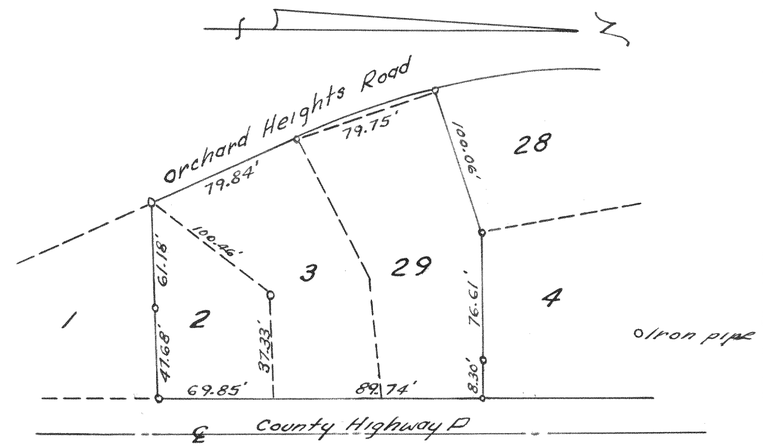

○ Iron pipe

Plat of Survey of Lots 2, 3 & 29, Block F, Crystal Bowl Subdivision, Located in NW 1/4 of Section 13, T3N, R15E, Walworth County, Wisconsin.
Lloyd L. Jensen
County Surveyor