260

#3828

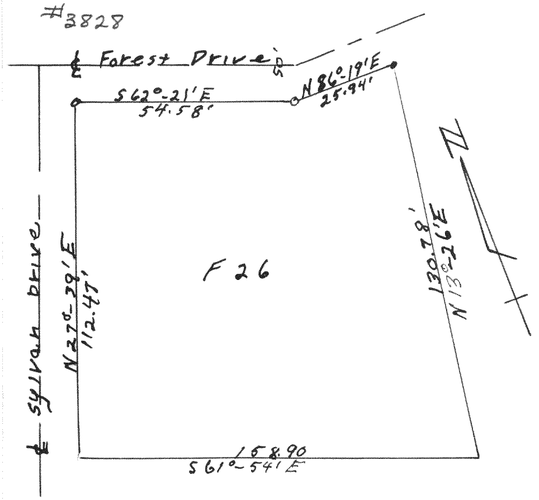

Plat of Survey of Lot F26, Add F to Country Club Estates, Village of Fontana, Walworth County Wisconsin Nov. 1959
Lloyd L. Jensen County Surveyor

#3829

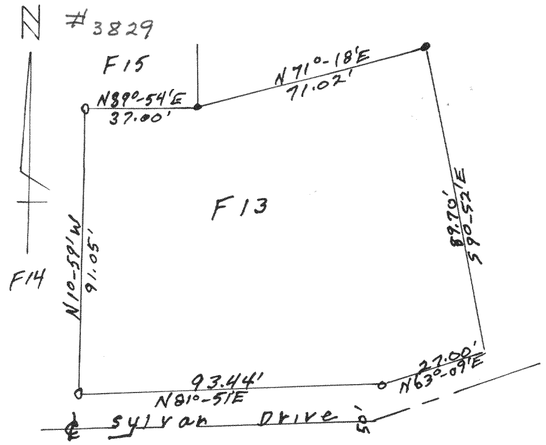

Plat of survey of Lot F 13, Add F to Country Club Estates, Village of Fontana, Walworth County Wisconsin Aug. 1959
Lloyd L. Jensen
County Surveyor

#3830

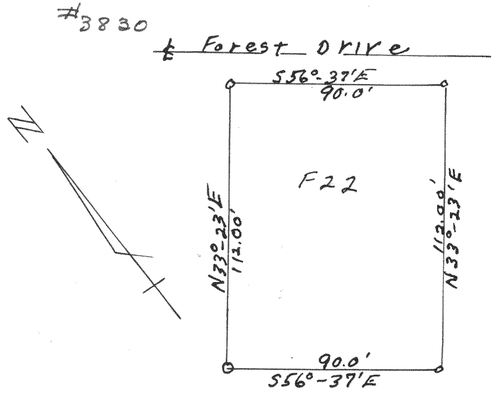

Plat of Survey of Lot F22 Add F To Country Club Estates, Village of Fontana, Walworth County Wisconsin July 1959
Lloyd L. Jensen
County Surveyor

#3831

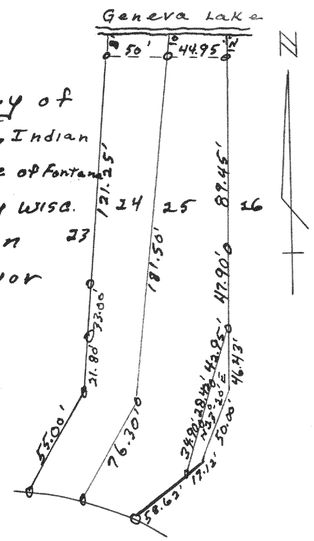

Plat of Survey of Lots 24 & 25, Blk 1, Indian Hills Subd. Village of Fontana Walworth County Wisc.
Lloyd L. Jensen
County Surveyor
Nov. 1959

#3832

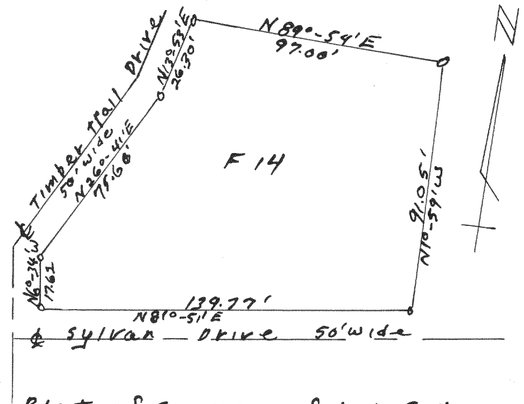

Plat of survey of Lot F14 Add F to Country Club Estates, Village of Fontana, Walworth County Wisconsin May 1959
Lloyd L. Jensen
County Surveyor

#3833

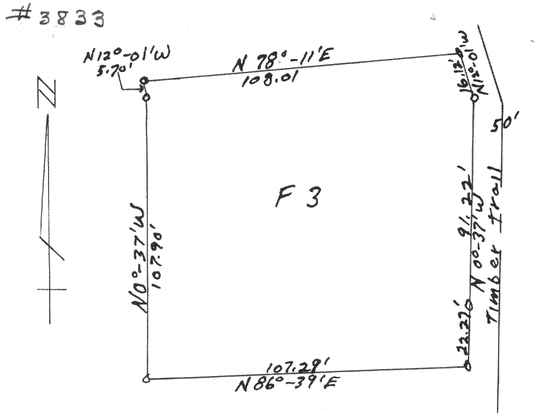

Plat of Survey of Lot F3 Add. F to Country Club Estates Village of Fontana, Walworth County Wisconsin July 1959
Lloyd L. Jensen
County Surveyor