562

4416

TOPOGRAPHIC MAP
LOT 4 CEYLON COURT ESTATES
CITY OF LAKE GEVENA - WALWORTH
COUNTY, WISCONSIN.
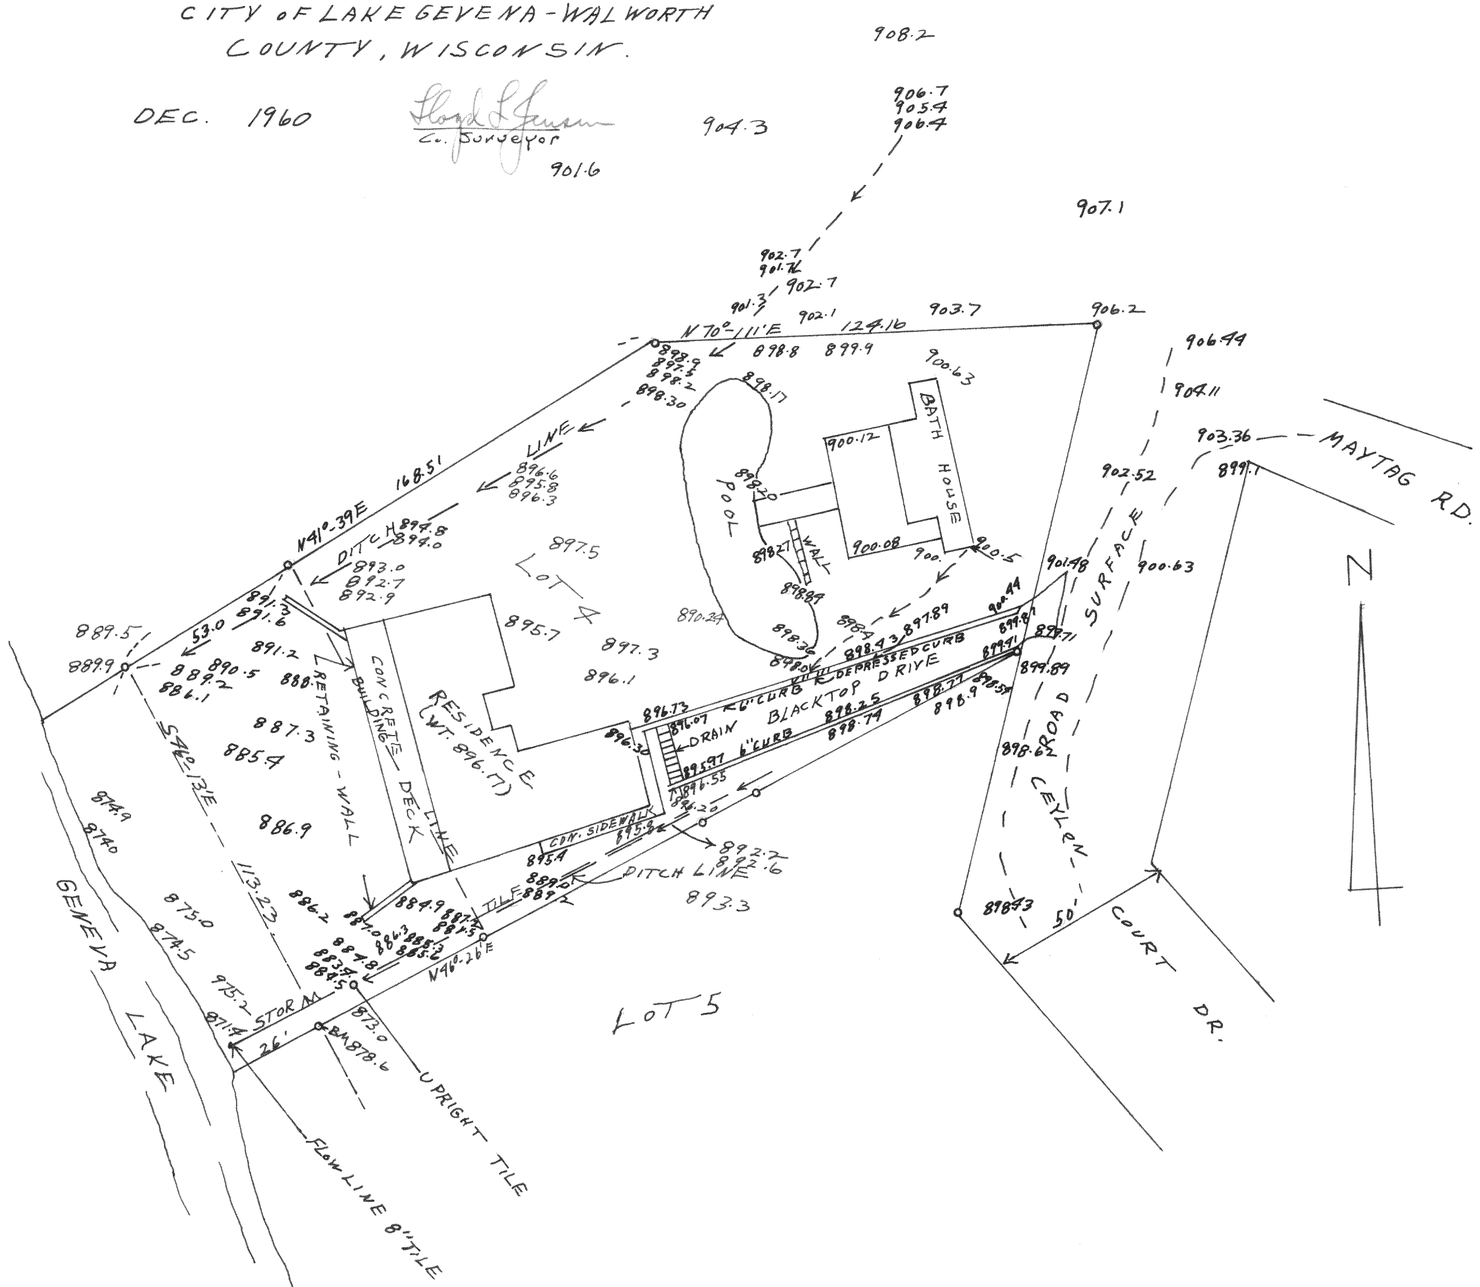
DEC. 1960 Floyd L Jensen Co. Surveyor