894

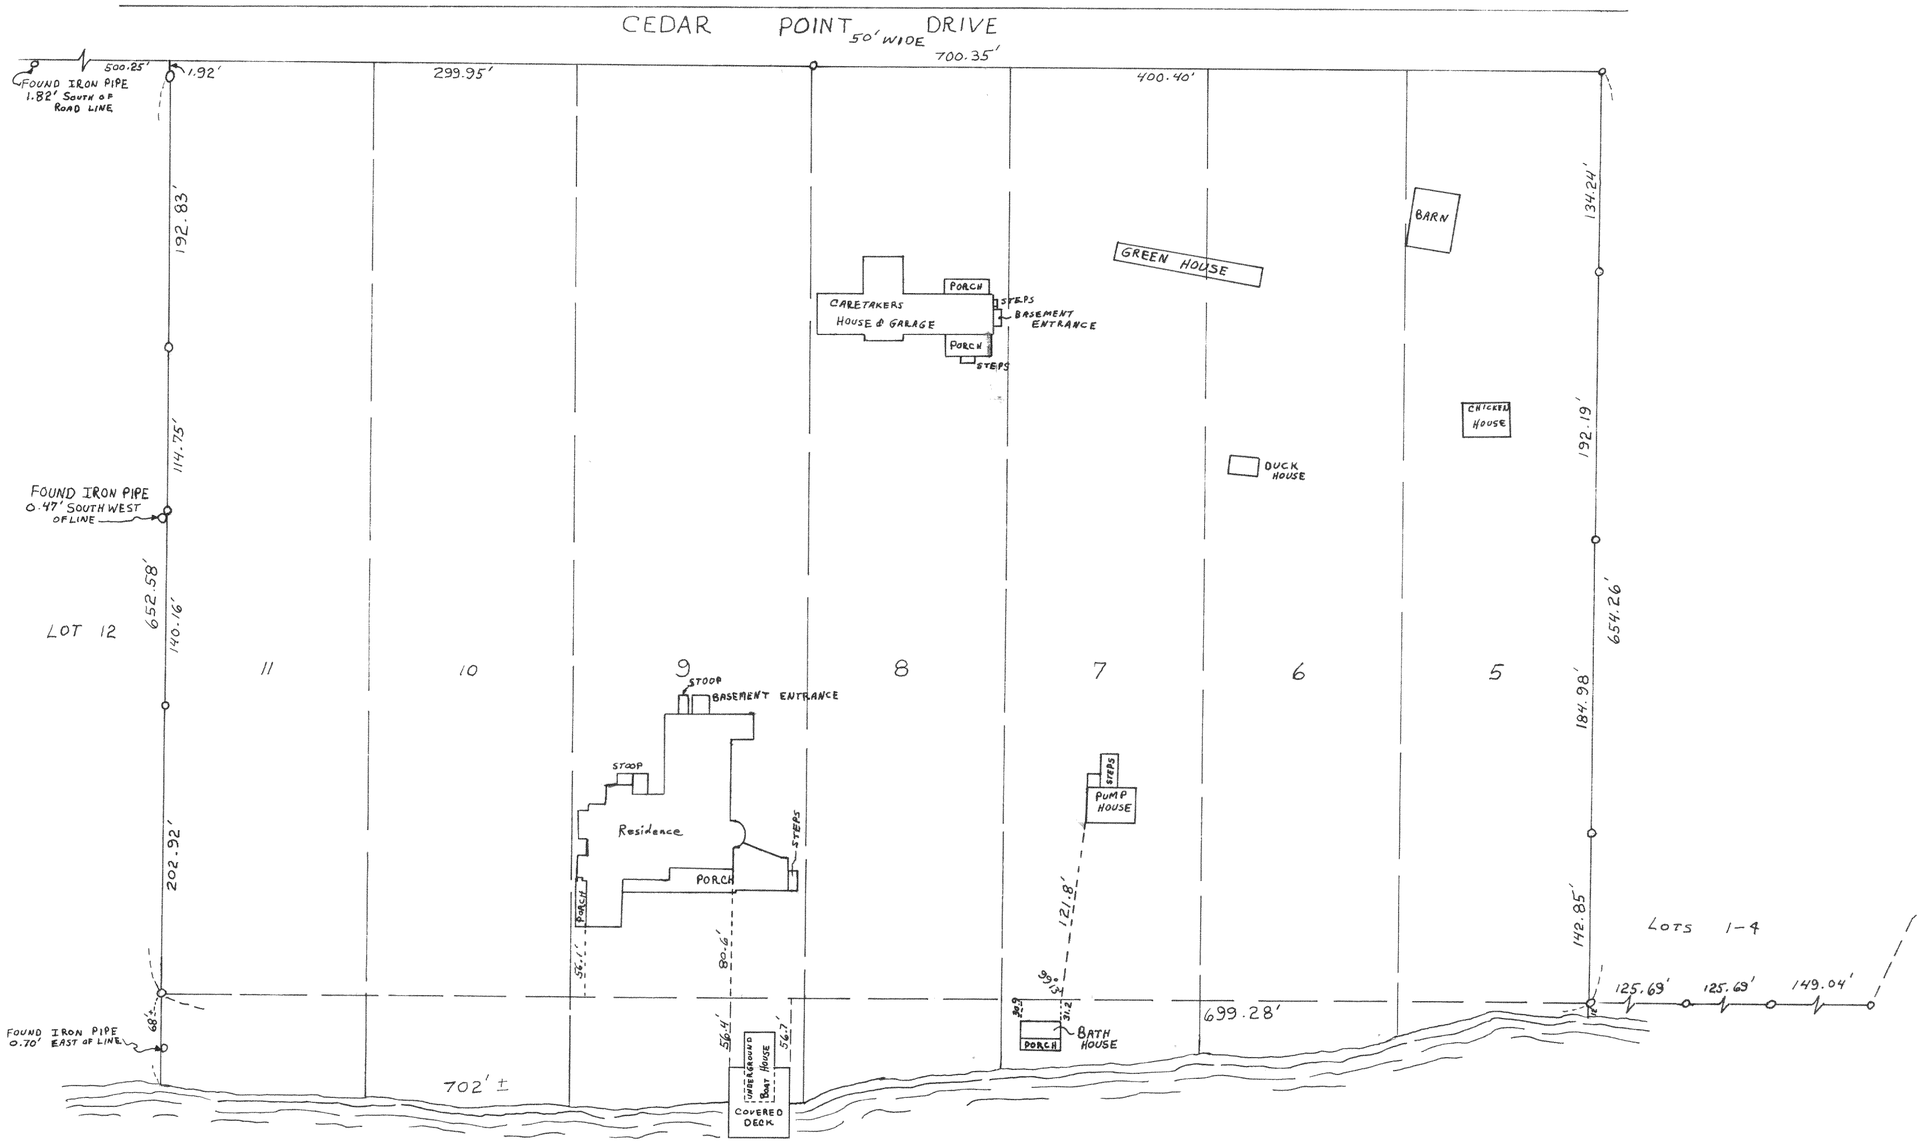

PLAT OF SURVEY #4913
OF

LOTS 5,6,7,8,9,10 AND 11 OF CEDAR POINT SUBDIVISION LOCATED IN THE VILLAGE OF WILLIAMS BAY AND TOWN 1 NORTH RANGE 17 EAST OF WALWORTH COUNTY WISCONSIN

SEPT 1967

Lloyd L Jensen
COUNTY SURVEYOR