3546

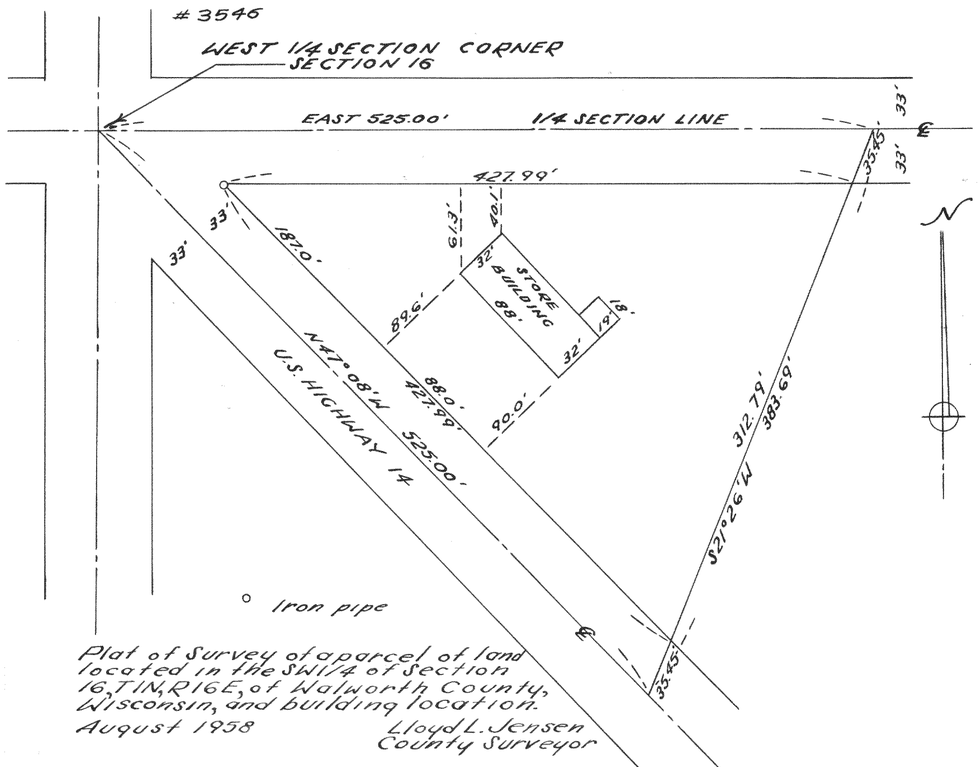

Plat of Survey of a parcel of land located in the SW1/4 of Section 16, T1N, R16E, of Walworth County, Wisconsin, and building location.
August 1958
Lloyd L. Jensen
County Surveyor

3547

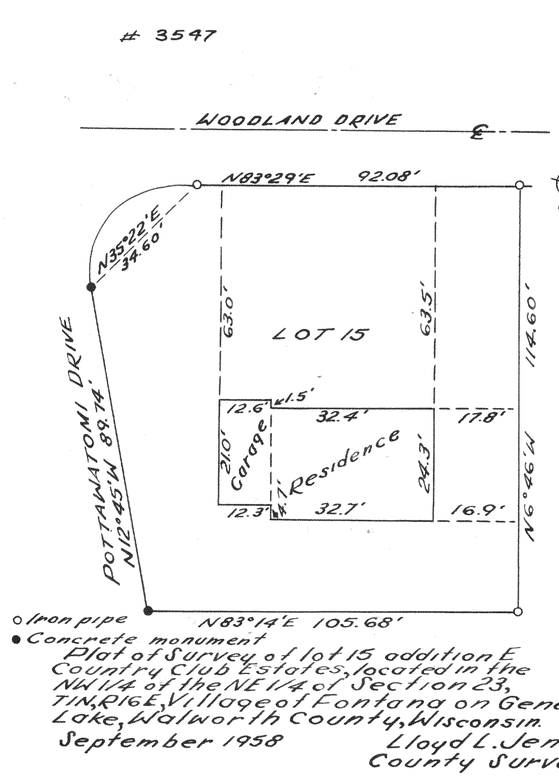

○ Iron pipe
● Concrete monument

Plat of Survey of lot 15 addition E Country Club Estates, located in the NW1/4 of the NE1/4 of Section 23, T1N, R16E, Village of Fontana on Geneva Lake, Walworth County, Wisconsin.
September 1958
Lloyd L. Jensen
County Surveyor

3548

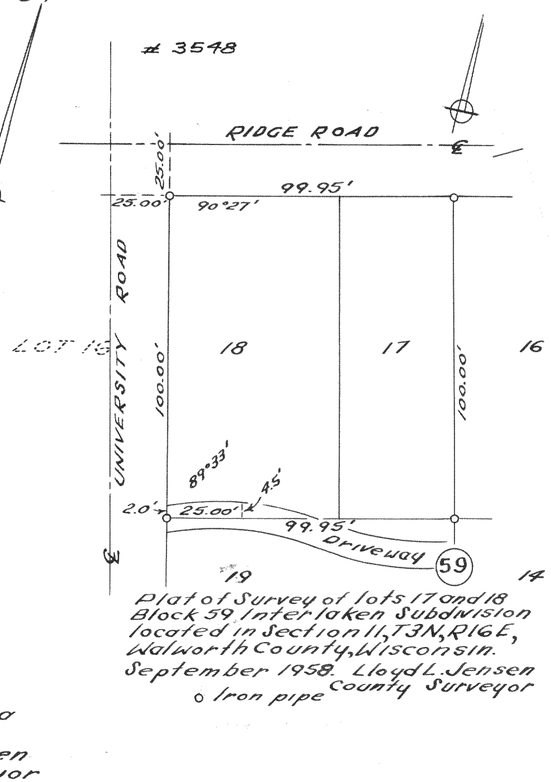

Plat of Survey of lots 17 and 18 Block 59 Interlaken Subdivision located in Section 11, T3N, R16E, Walworth County, Wisconsin.
September 1958. Lloyd L. Jensen
County Surveyor

○ Iron pipe

3549

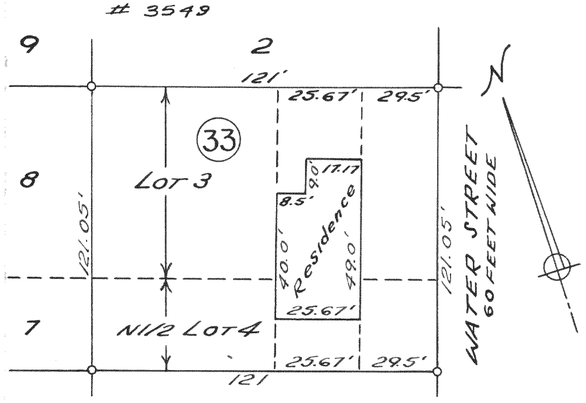

Plat of Survey of lot 3 and North 1/2 of lot 4 of Block 33 of the original plat of the Village of Waterford, Racine County, Wisconsin.
September 1958
Lloyd L. Jensen
County Surveyor

○ Iron pipe

3550

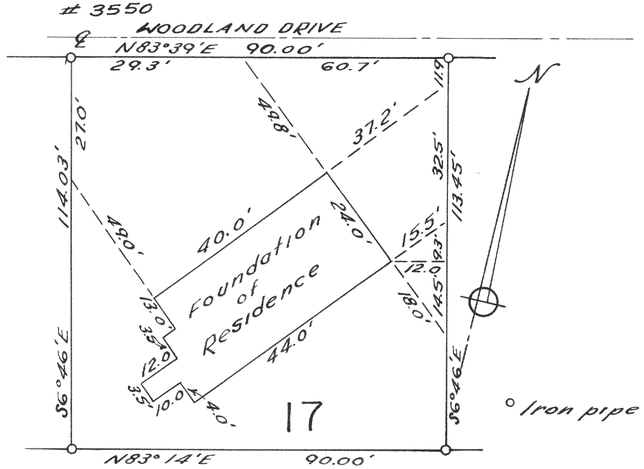

○ Iron pipe

Plat of Survey of lot 17, addition E Country Club Estates, located in the NW1/4 of the NE1/4 of Section 23 T1N, R16E, Village of Fontana on Geneva Lake, Walworth County, Wisconsin.
September 1958
Lloyd L. Jensen
County Surveyor

3551

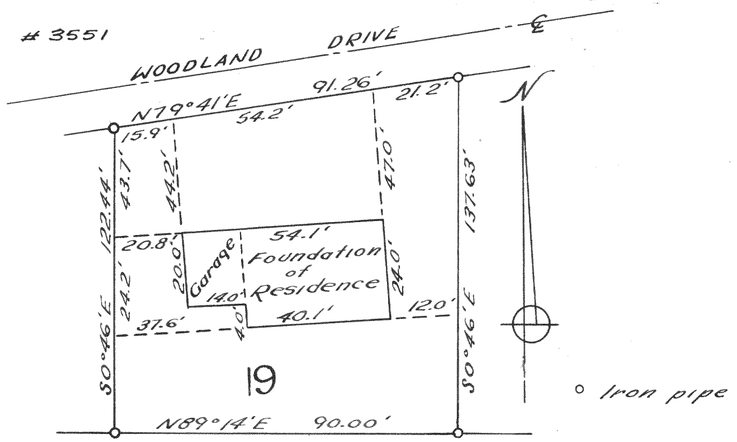

○ Iron pipe

Plat of Survey of lot 19, addition E Country Club Estates, located in the NW1/4 of the NE1/4 of Section 23 T1N, R16E, Village of Fontana, on Geneva Lake, Walworth County, Wisconsin
September 1958
Lloyd L. Jensen
County Surveyor