#3602

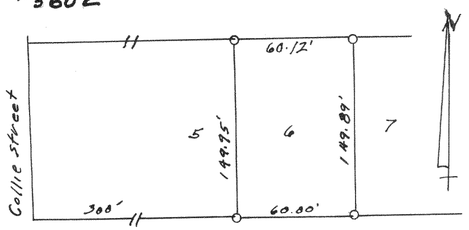

Survey of Lot 6 of Jewell Subdivision,
Village of Williams Bay
Aug. 1957 Lloyd L Jensen
County Surveyor

#3605

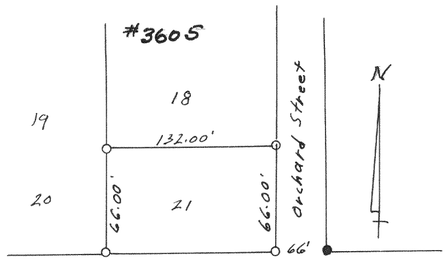

Survey of Lot 21
Add.
Lockwood ~~Subd~~, Village
of Williams Bay
Nov. 1957 Lloyd L Jensen
County Surveyor

PLAT OF SURVEY OF A PARCEL OF LAND LOCATED IN THE N½ OF FRACTIONAL SECTION 13, T1N, R16E VILLAGE OF FONTANA ON GENEVA LAKE WALWORTH COUNTY WISCONSIN
JUNE, 57 LLOYD L. JENSEN COUNTY SURVEYOR

#3608

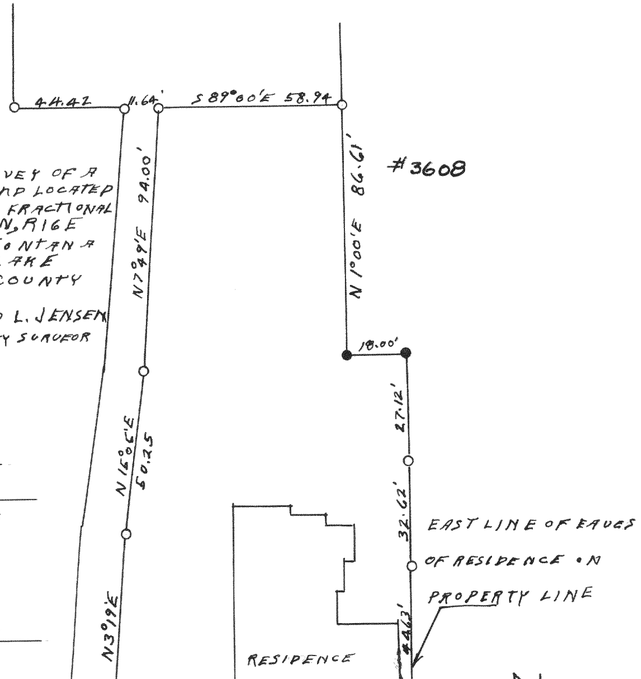

#3606

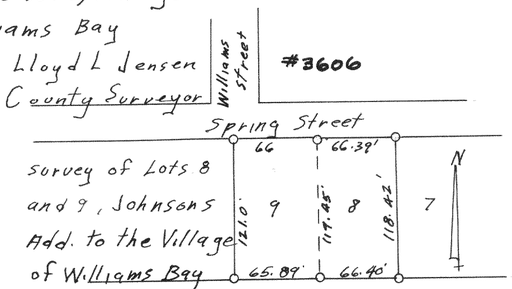

Aug. 1957 Lloyd L. Jensen
County Surveyor

#3607

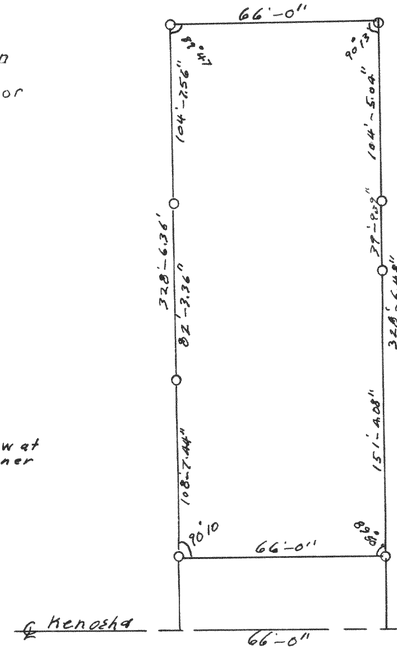

Survey of Outlot
176 Village of Walworth

#3603

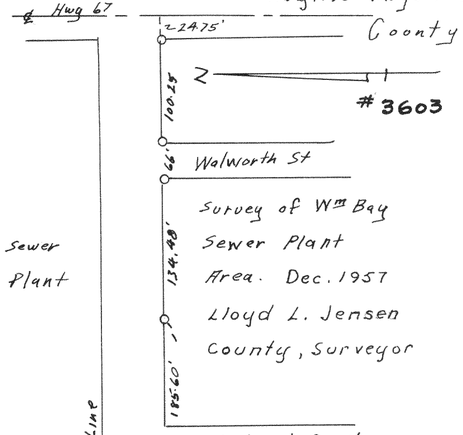

#3604

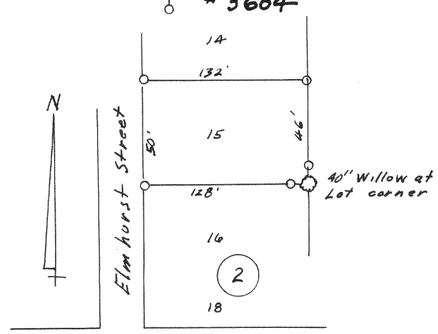

Oct. 1958 Survey of Lot 16,
Blk 2, Starks Subdivision
Village of Williams Bay Lloyd L. Jensen