334

4067

PLAT of ROAD AS TRAVELED IN SEC. 17, T4N, R18E, (EAST TROY) TO SHOW LOCATION IN RELATION TO THE RECORDED DESCRIBED RIGHT of WAYS
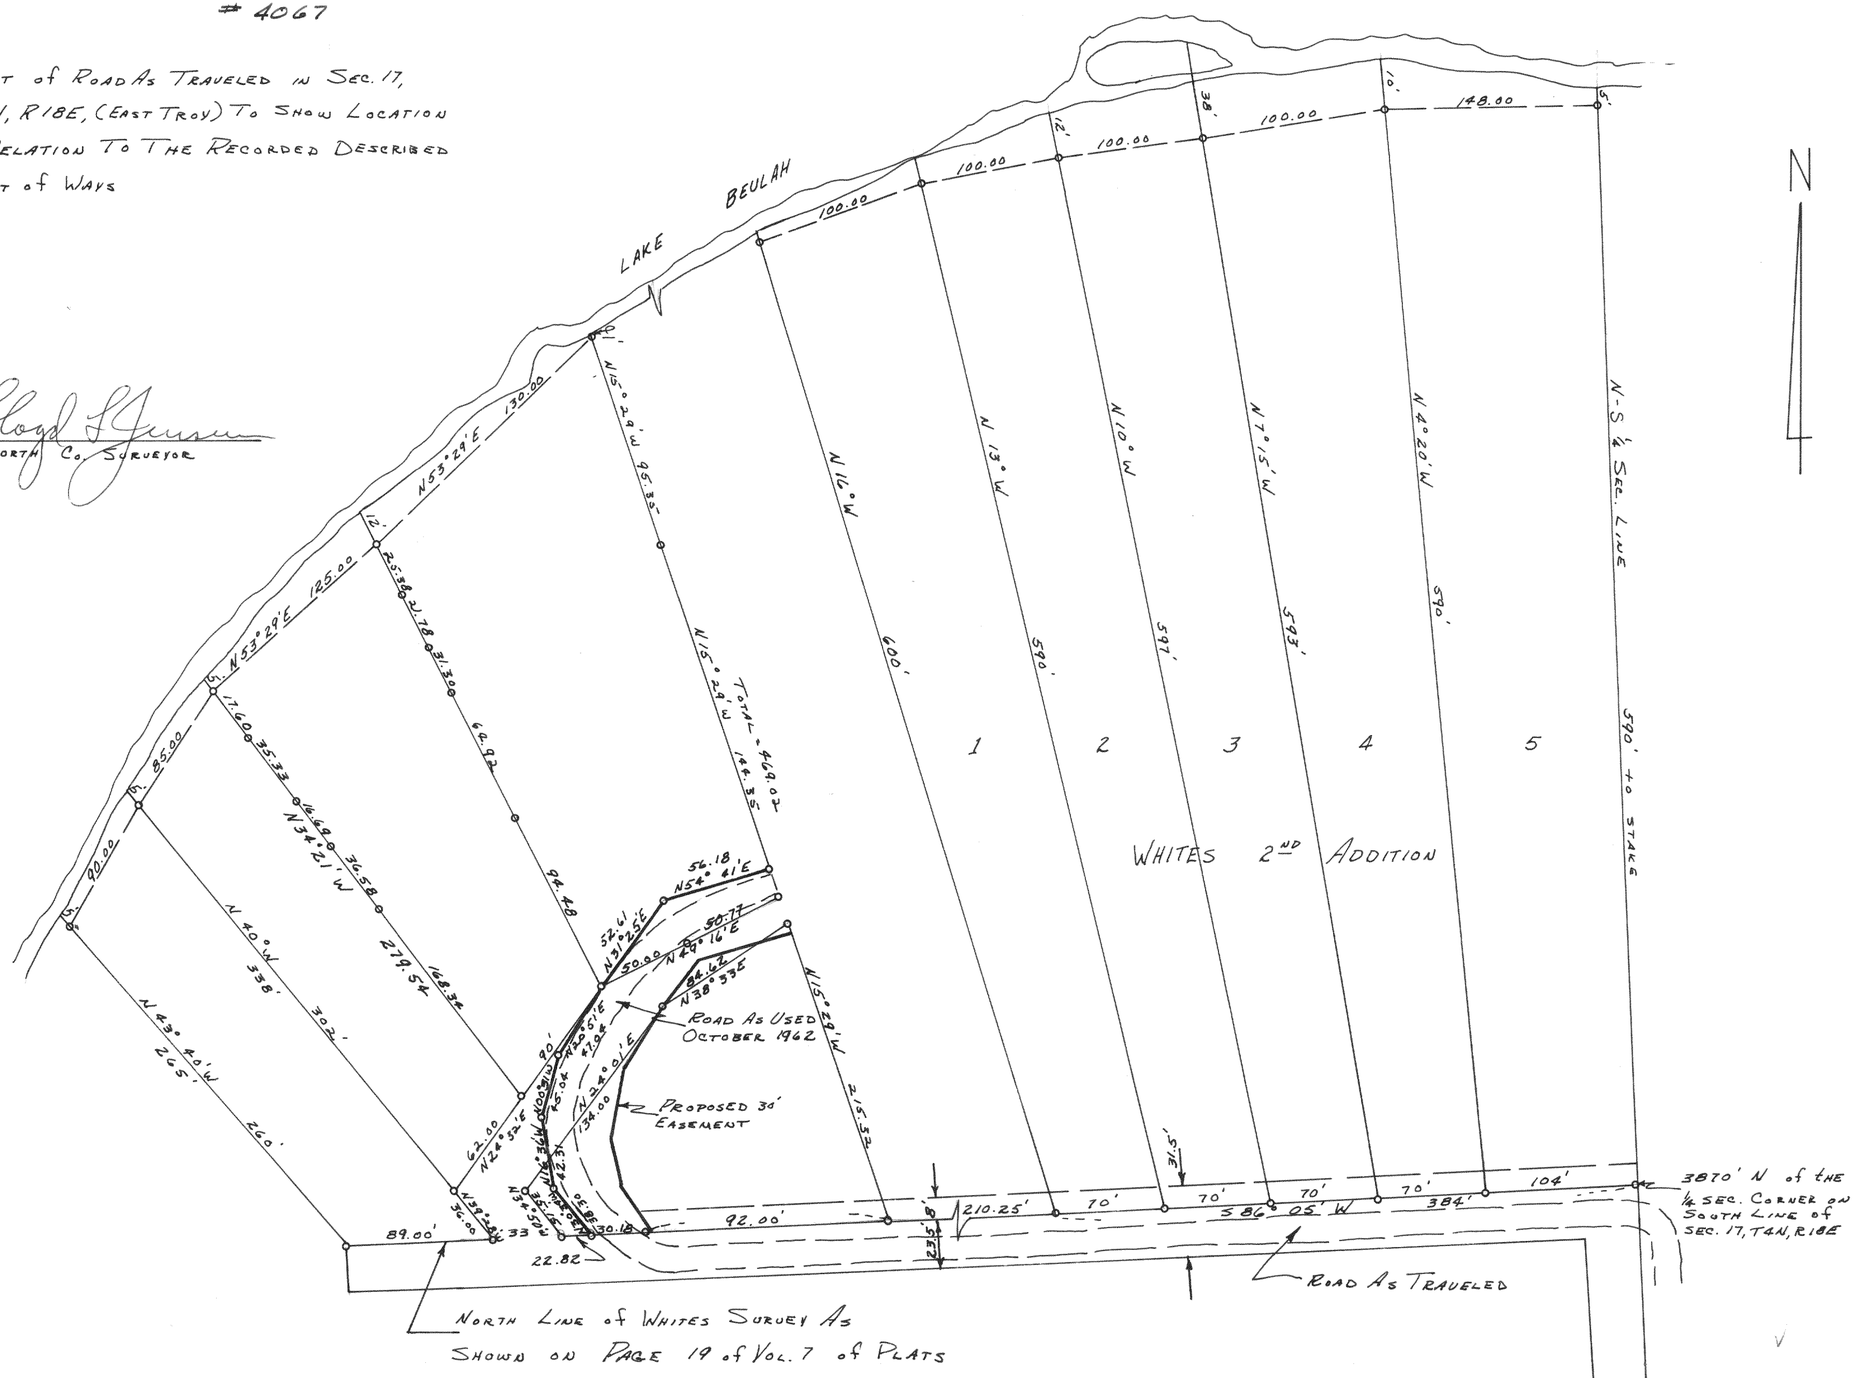
OCT 1962 Floyd L Jensen
WALWORTH Co. SURVEYOR