476

#4275 PLAT OF SURVEY OF
LOT F 26, ADDITION F TO COUNTRY CLUB ESTATES, VILLAGE OF FONTANA-ON-GENEVA-LAKE, WALWORTH COUNTY, WISCONSIN.

JULY 1964

Floyd L Jensen
C.G. SURVEYOR

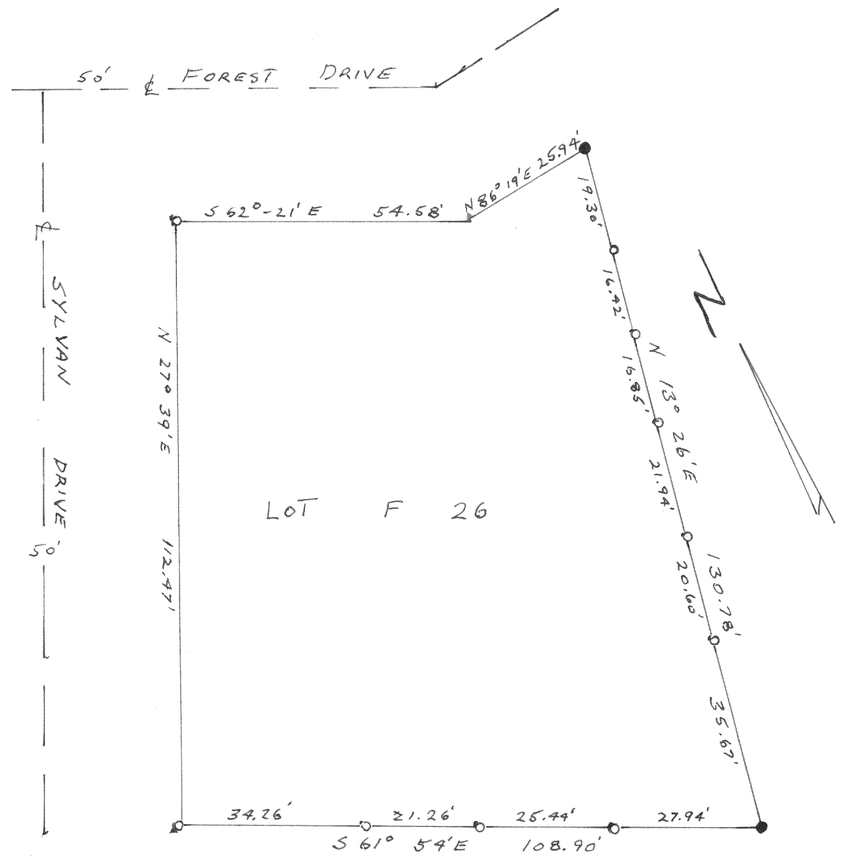

#4276 PLAT OF SURVEY OF
LOT F 31, ADDITION F TO COUNTY CLUB ESTATES, VILLAGE OF FONTANA-ON-GENEVA-LAKE, WALWORTH COUNTY, WISCONSIN.

JULY 1964
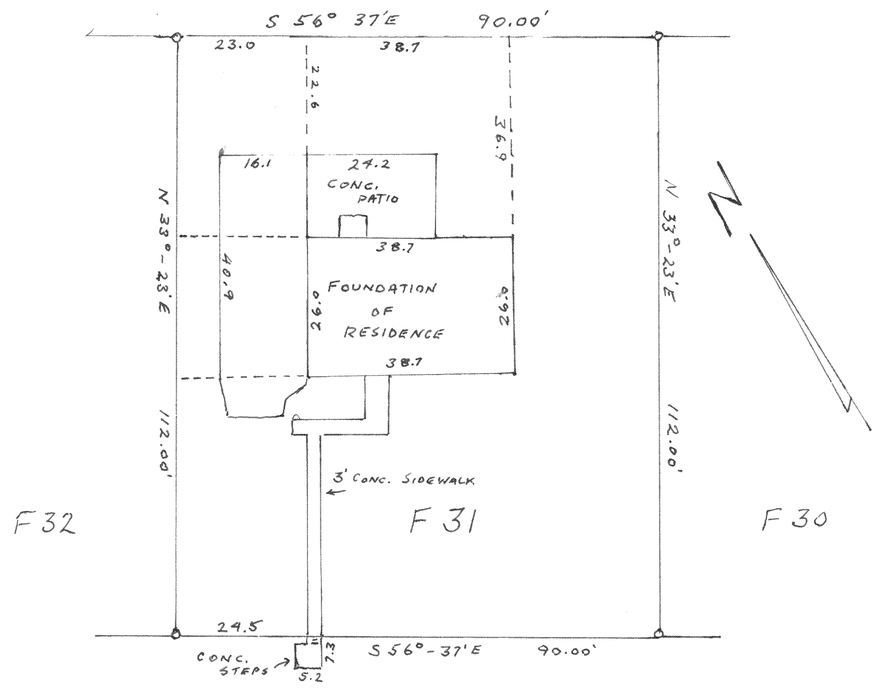
Floyd L Jensen
C.G. SURVEYOR