NOTE: SURVEYOR'S CERTIFICATE FOR ADDITION NO I TO ROSE CREST ADDITION GIVES THE DISTANCE FROM THE WEST 1/4 SECTION CORNER OF SEC. 5, T4N R15E AS 1333.78 FEET. A FIELD SURVEY OF THIS LINE FOUND THIS DISTANCE TO BE 1335.30 FEET. THE FIELD SURVEY GIVES AN OVER RUN OF 1.52 FEET. NO NO EFFORT WAS MADE TO APPORTION THIS OVER RUN AMONG THE PROPERTIES BETWEEN THE WEST 1/4 SECTION CORNER OF SEC. 5 AND THE SOUTHWEST CORNER OF ROSE CREST ADDITION.

## CURVE DATA

① C = N46°-54'-15"E 38.53 I = 100°-48'-30" R = 25.00'
② C = N78°-32'-05"W 19.43' I = 8°-18'-50" R = 134.00'
③ C = N83°-57'-21"W 66.56' I = 19°-09'-23" R = 200.00'
④ C = N51°-03'-40"E 40.74' I = 109°-07'-20" R = 25.00'

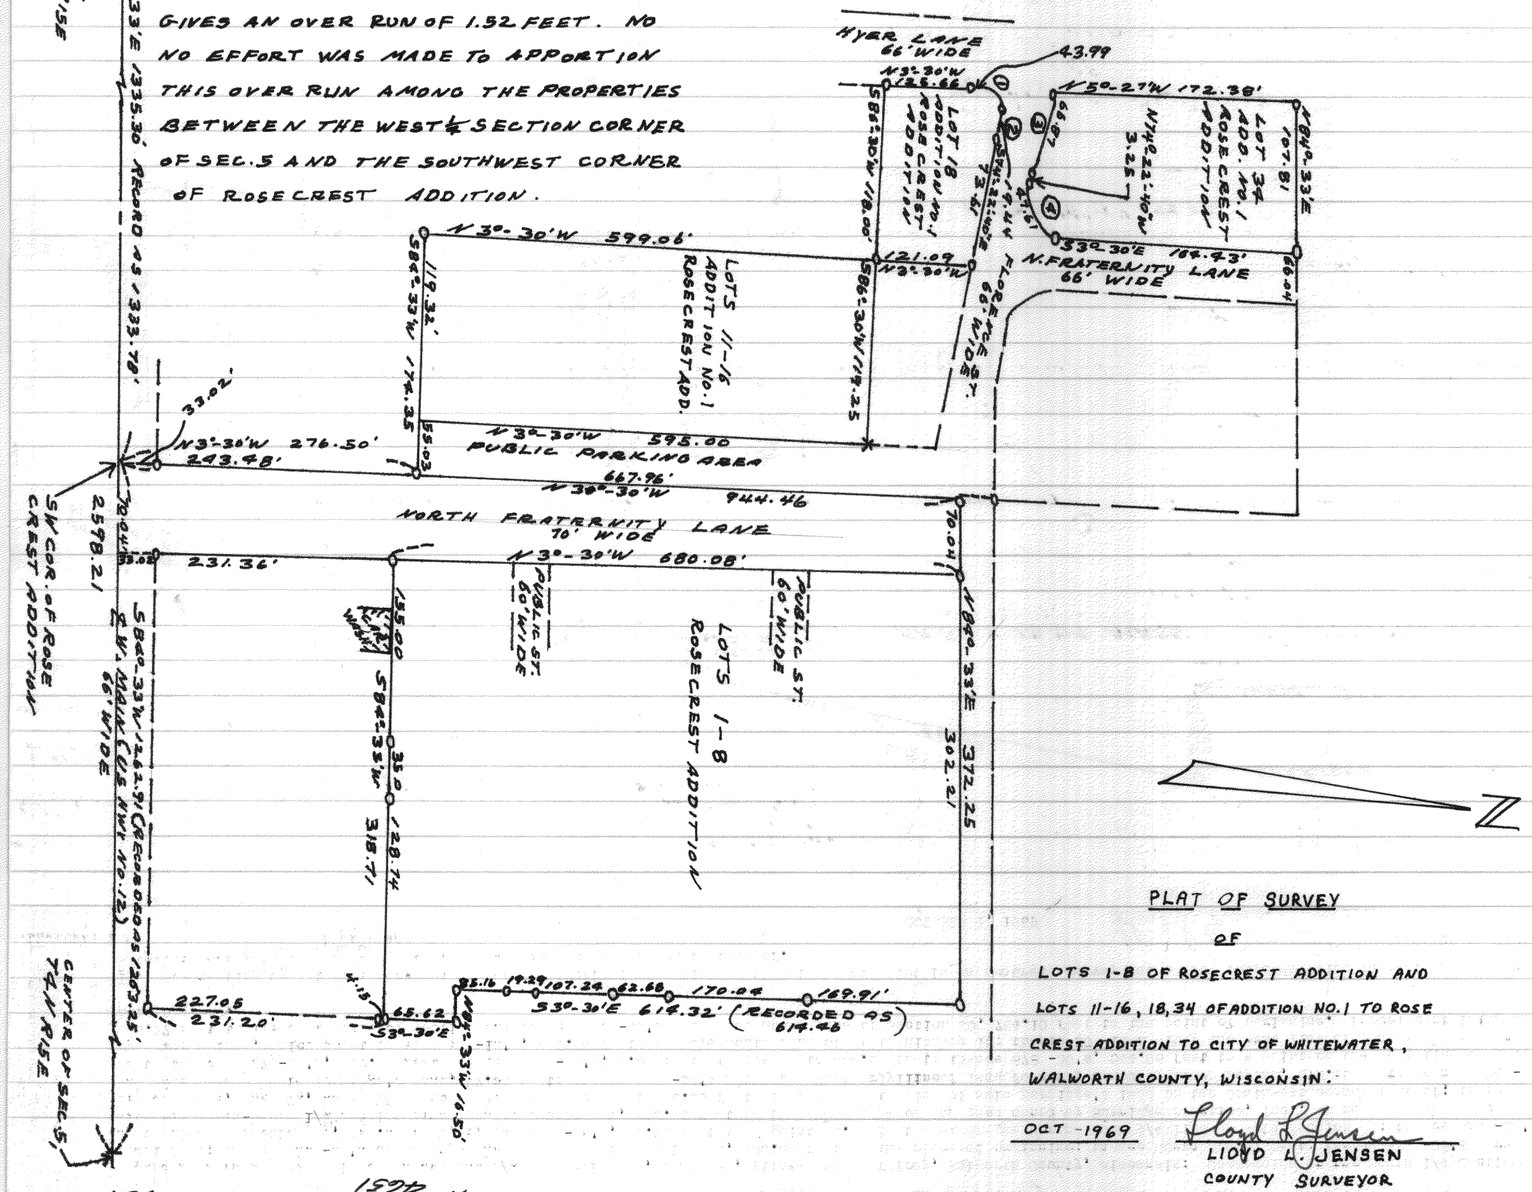


PLAT OF SURVEY

OF

LOTS 1-8 OF ROSECREST ADDITION AND LOTS 11-16, 18, 34 OF ADDITION NO. 1 TO ROSE CREST ADDITION TO CITY OF WHITEWATER, WALWORTH COUNTY, WISCONSIN.

OCT - 1969

Lloyd L. Jensen
LLOYD L. JENSEN
COUNTY SURVEYOR

759

# 4651