#2962

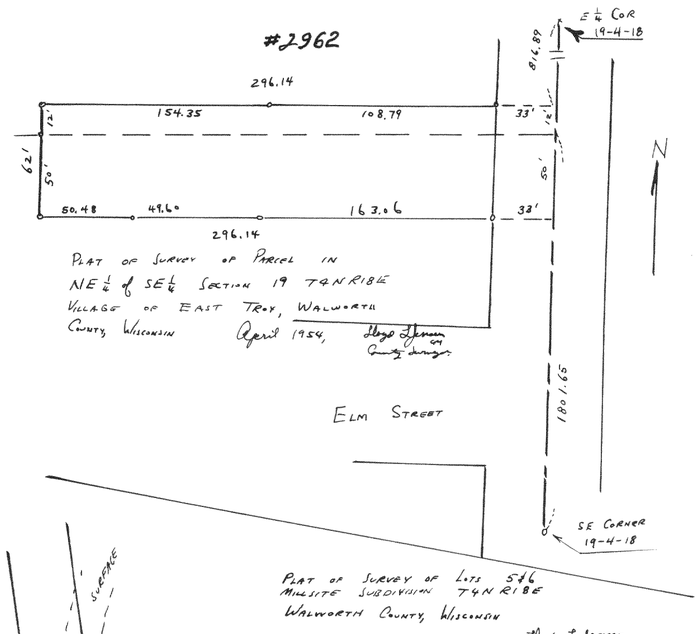

PLAT OF SURVEY OF PARCEL IN NE ¼ of SE ¼ SECTION 19 T4N R18E VILLAGE OF EAST TROY, WALWORTH COUNTY, WISCONSIN

April 1954, Lloyd L Jones CE County Surveyor

#2963

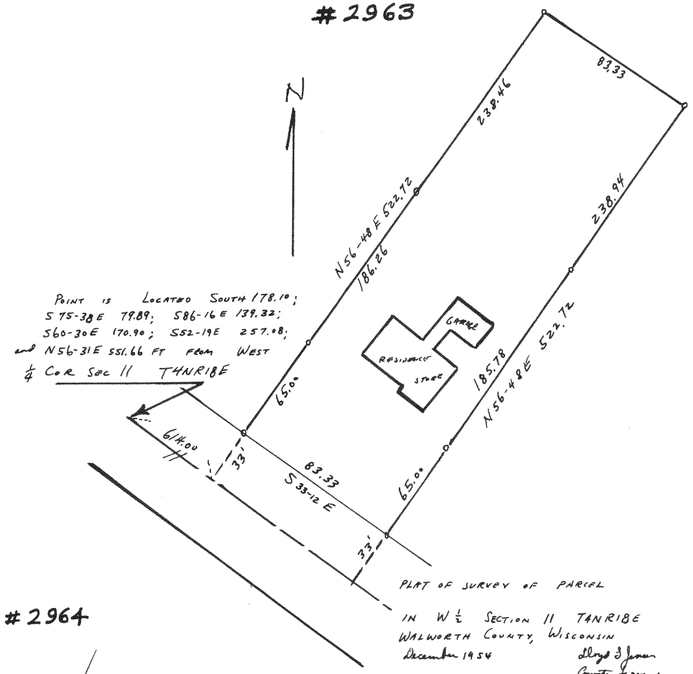

PLAT OF SURVEY OF PARCEL IN W ½ SECTION 11 T4N R18E WALWORTH COUNTY, WISCONSIN

December 1954 Lloyd J Jones County Surveyor

#2964

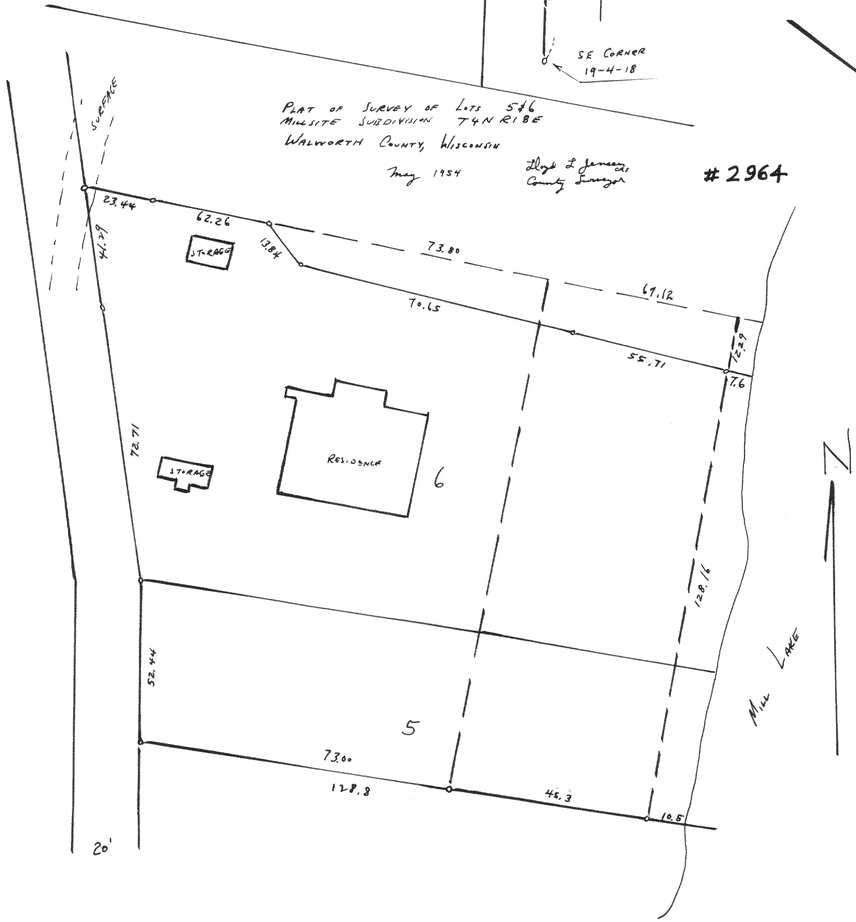

PLAT OF SURVEY OF LOTS 5 & 6 MILLSITE SUBDIVISION T4N R18E WALWORTH COUNTY, WISCONSIN

May 1954 Lloyd L Jones CE County Surveyor

#2965

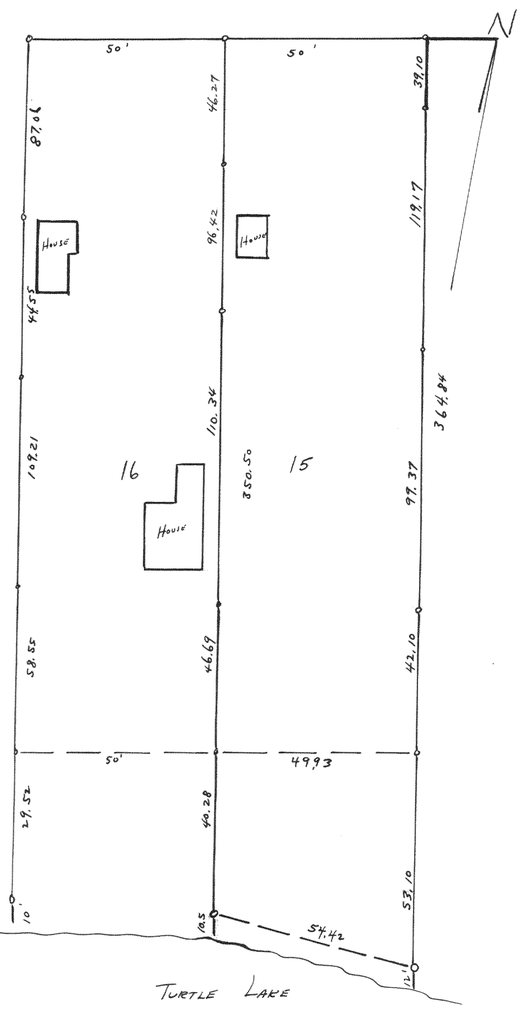

PLAT OF SURVEY OF LOTS 15 & 16 OAK PARK IN T3N R15E WALWORTH COUNTY WISCONSIN

July 1954 Lloyd L Jones County Surveyor