FOR SURVEY OF SKINEYS SUBDIVISION LOCATED IN THE SE¼ SW¼ AND THE SW¼ SE¼ OF FR SECTION 10, T4N R18E WALWORTH COUNTY, WISCONSIN. SEE VOLUME ____, PAGE ____ IN WALWORTH COUNTY PLAT RECORDS

#2973

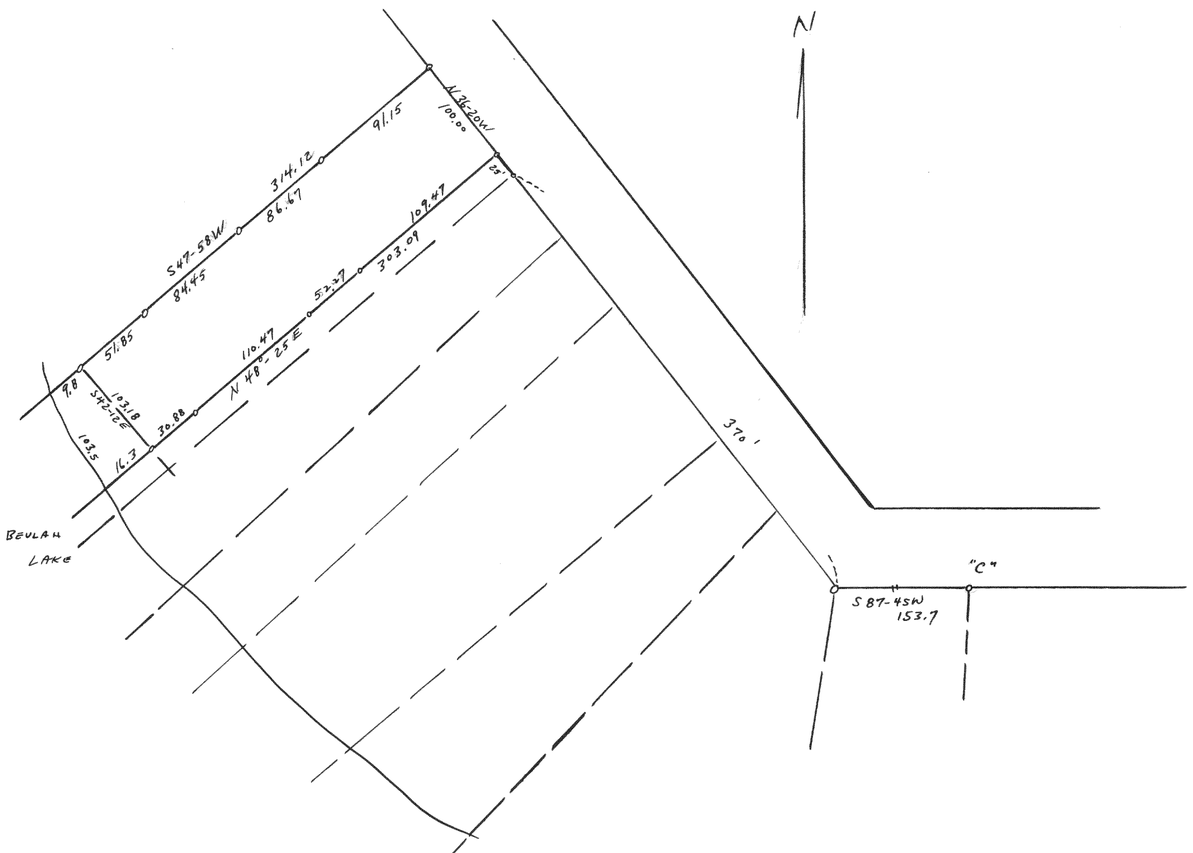

PLAT OF SURVEY OF
PARCEL IN NW¼ OF SECTION 4, T4N R18E
PART OF WILLIAMS PARK, WALWORTH COUNTY, WIS

July 1954

Lloyd L Jones CRS
County Surveyor

#2974

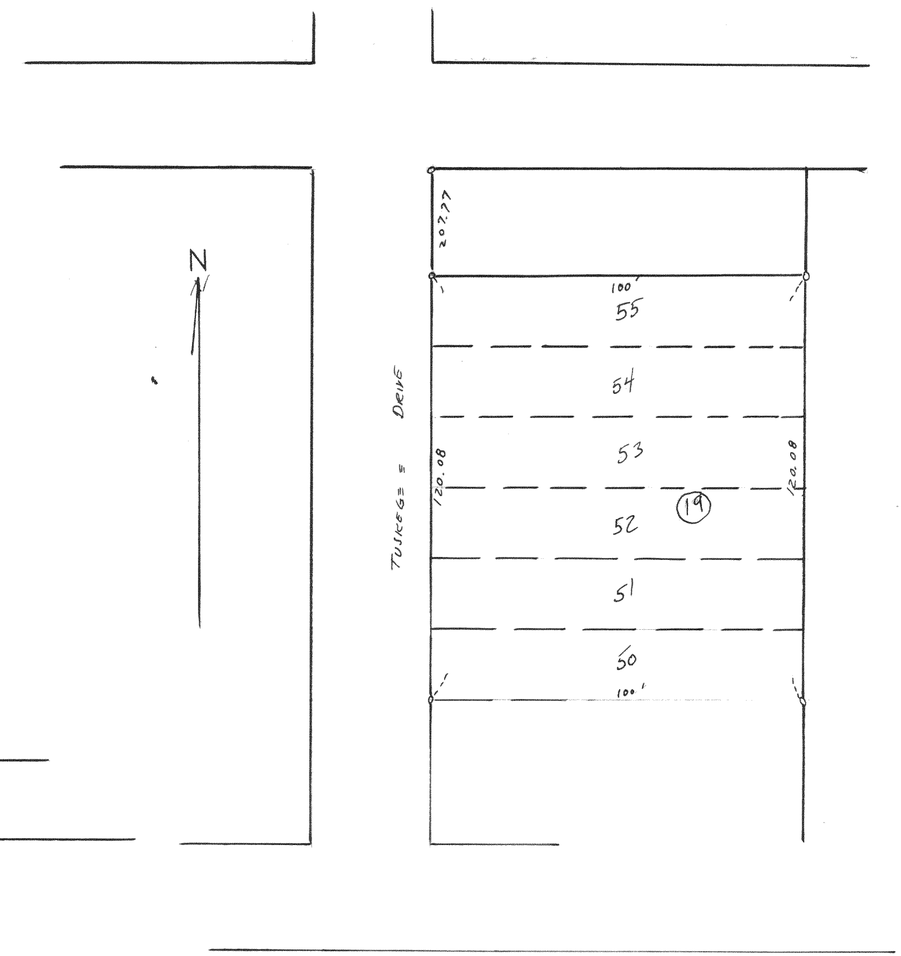

PLAT OF SURVEY OF
LOTS 50-55, BLOCK 19 OF LAKE IVANHOE RESORT
T1N R18E, WALWORTH COUNTY, WISCONSIN

July 1954

Lloyd L Jones CRS
County Surveyor